


1 LOCATION OF WATER WELL: County: Montgomery Fraction SW 1/4 SW 1/4 NW 1/4 Section Number 33 Township Number T 34 S Range Number R 16 EW

Distance and direction from nearest town or city street address of well if located within city?
3806 W First St Coffeyville KS

2 WATER WELL OWNER: Williams Pipeline
RR#, St. Address, Box #: 10200 W 75th Suite 270
City, State, ZIP Code: Shawnee Mission KS. 66204
Board of Agriculture, Division of Water Resources
Application Number:

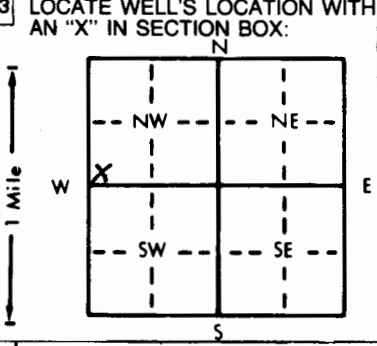

4 DEPTH OF COMPLETED WELL: 13.8 ft. ELEVATION: 790.42

Depth(s) Groundwater Encountered 1. _____ ft. 2. _____ ft. 3. _____ ft.

WELL'S STATIC WATER LEVEL _____ ft. below land surface measured on mo/day/yr _____

Pump test data: Well water was _____ ft. after _____ hours pumping _____ gpm

Est. Yield _____ gpm: Well water was _____ ft. after _____ hours pumping _____ gpm

Bore Hole Diameter: 4.5 in. to 13.2 ft., and _____ in. to _____ ft.

WELL WATER TO BE USED AS:

5 Public water supply	8 Air conditioning	11 Injection well
1 Domestic	3 Feedlot	6 Oil field water supply
2 Irrigation	4 Industrial	7 Lawn and garden only
		<input checked="" type="checkbox"/> 10 Monitoring well
		9 Dewatering
		12 Other (Specify below)

Was a chemical/bacteriological sample submitted to Department? Yes _____ No ; If yes, mo/day/yr sample was submitted _____

Water Well Disinfected? Yes _____ No

5 TYPE OF BLANK CASING USED:

1 Steel	3 RMP (SR)	5 Wrought iron	8 Concrete tile	CASING JOINTS: Glued _____ Clamped _____
<input checked="" type="radio"/> 2 PVC	4 ABS	6 Asbestos-Cement	9 Other (specify below)	Welded _____
Blank casing diameter <u>4</u> in. to <u>4.0</u> ft., Dia _____ in. to _____ ft., Dia _____ in. to _____ ft.		7 Fiberglass		Threaded <input checked="" type="checkbox"/>
Casing height above land surface <u>0.0</u> in., weight <u>5ch 4.0</u> lbs./ft. Wall thickness or gauge No. _____				

TYPE OF SCREEN OR PERFORATION MATERIAL:

1 Steel	3 Stainless steel	5 Fiberglass	8 RMP (SR)	10 Asbestos-cement
2 Brass	4 Galvanized steel	6 Concrete tile	9 ABS	11 Other (specify) _____
SCREEN OR PERFORATION OPENINGS ARE:				12 None used (open hole)
1 Continuous slot	<input checked="" type="radio"/> 2 Mill slot	5 Gauzed wrapped	8 Saw cut	11 None (open hole)
2 Louvered shutter	4 Key punched	6 Wire wrapped	9 Drilled holes	
SCREEN-PERFORATED INTERVALS: From <u>4.0</u> ft. to <u>13.8</u> ft., From _____ ft. to _____ ft.		7 Torch cut	10 Other (specify) _____	
GRAVEL PACK INTERVALS: From <u>3.0</u> ft. to <u>13.8</u> ft., From _____ ft. to _____ ft.				

6 GROUT MATERIAL: Neat cement 2 Cement grout Bentonite 4 Other _____

Grout Intervals: From 0.0 ft. to 3.0 ft., From _____ ft. to _____ ft., From _____ ft. to _____ ft.

What is the nearest source of possible contamination:

1 Septic tank	4 Lateral lines	7 Pit privy	<input checked="" type="radio"/> 10 Livestock pens	14 Abandoned water well
2 Sewer lines	5 Cess pool	8 Sewage lagoon	11 Fuel storage	15 Oil well/Gas well
3 Watertight sewer lines	6 Seepage pit	9 Feedyard	12 Fertilizer storage	16 Other (specify below)
			13 Insecticide storage	

Direction from well? _____ How many feet? _____

FROM	TO	LITHOLOGIC LOG	FROM	TO	PLUGGING INTERVALS
0.0	1.0	Topsoil DK Br			
1.0	2.0	Shale Br			
2.0	13.8	sand stone Br to G-			

7 CONTRACTOR'S OR LANDOWNER'S CERTIFICATION: This water well was constructed, (2) reconstructed, or (3) plugged under my jurisdiction and was completed on (mo/day/year) 11/2/93 and this record is true to the best of my knowledge and belief. Kansas Water Well Contractor's License No. 416 This Water Well Record was completed on (mo/day/yr) 3/1/94 under the business name of Terracon Consultants Inc by (signature) Richard D. [Signature]