


1 LOCATION OF WATER WELL: Fraction SW 1/4 SW 1/4 NW 1/4 Section Number 33 Township Number T 34 S Range Number R 16 W
 County: Montgomery

Distance and direction from nearest town or city street address of well if located within city?
3806 West First Street Coffeyville KS

2 WATER WELL OWNER: Williams Pipeline
 RR#, St. Address, Box #: 10200 W 75th - surte 270
 City, State, ZIP Code: Shawnee Mission KS 66204
 Board of Agriculture, Division of Water Resources
 Application Number:

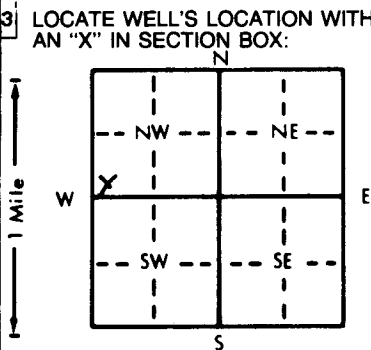

4 DEPTH OF COMPLETED WELL: 13.4 ft. ELEVATION: 802.72
 Depth(s) Groundwater Encountered 1. 8.08 ft. 2. — ft. 3. — ft.
 WELL'S STATIC WATER LEVEL: 8.08 ft. below land surface measured on mo/day/yr 12/7/93
 Pump test data: Well water was — ft. after — hours pumping — gpm
 Est. Yield — gpm: Well water was — ft. after — hours pumping — gpm
 Bore Hole Diameter: 4.8 in. to 13.4 ft. and — in. to — ft.
 WELL WATER TO BE USED AS:
 5 Public water supply 8 Air conditioning 11 Injection well
 1 Domestic 3 Feedlot 6 Oil field water supply 9 Dewatering 12 Other (Specify below)
 2 Irrigation 4 Industrial 7 Lawn and garden only Monitoring well
 Was a chemical/bacteriological sample submitted to Department? Yes — No ; If yes, mo/day/yr sample was submitted
 Water Well Disinfected? Yes — No

5 TYPE OF BLANK CASING USED:
 1 Steel 3 RMP (SR) 5 Wrought iron 8 Concrete tile CASING JOINTS: Glued — Clamped —
 2 PVC 4 ABS 6 Asbestos-Cement 9 Other (specify below) Welded —
 7 Fiberglass Threaded
 Blank casing diameter 2 in. to 3.5 ft. Dia — in. to — ft. Dia — in. to — ft.
 Casing height above land surface 0.0 in., weight Sch. 40 lbs./ft. Wall thickness or gauge No. —
 TYPE OF SCREEN OR PERFORATION MATERIAL:
 1 Steel 3 Stainless steel 5 Fiberglass 8 RMP (SR) 10 Asbestos-cement
 2 Brass 4 Galvanized steel 6 Concrete tile 9 ABS 11 Other (specify) —
 12 None used (open hole)
 SCREEN OR PERFORATION OPENINGS ARE:
 1 Continuous slot Mill slot 5 Gauzed wrapped 8 Saw cut 11 None (open hole)
 2 Louvered shutter 4 Key punched 6 Wire wrapped 9 Drilled holes
 7 Torch cut 10 Other (specify) —
 SCREEN-PERFORATED INTERVALS: From 3.3 ft. to 13.4 ft. From — ft. to — ft.
 From — ft. to — ft. From — ft. to — ft.
 GRAVEL PACK INTERVALS: From 3.0 ft. to 13.4 ft. From — ft. to — ft.
 From — ft. to — ft. From — ft. to — ft.

6 GROUT MATERIAL: Neat cement 2 Cement grout Bentonite 4 Other —
 Grout Intervals: From 0.0 ft. to 3.0 ft. From — ft. to — ft. From — ft. to — ft.
 What is the nearest source of possible contamination:
 1 Septic tank 4 Lateral lines 7 Pit privy Fuel storage 10 Livestock pens 14 Abandoned water well
 2 Sewer lines 5 Cess pool 8 Sewage lagoon 12 Fertilizer storage 15 Oil well/Gas well
 3 Watertight sewer lines 6 Seepage pit 9 Feedyard 13 Insecticide storage 16 Other (specify below)
 Direction from well? How many feet?

FROM	TO	LITHOLOGIC LOG	FROM	TO	PLUGGING INTERVALS
0.0	1.2	Topsoil Dk Gr			
1.2	3.3	shale Gr			
3.3	6.4	sandstone Gr			
6.4	9.0	shale Gr			
9.0	13.4	sandstone Gr.			

7 CONTRACTOR'S OR LANDOWNER'S CERTIFICATION: This water well was constructed, (2) reconstructed, or (3) plugged under my jurisdiction and was completed on (mo/day/year) 10/27/93 and this record is true to the best of my knowledge and belief. Kansas Water Well Contractor's License No. 416 This Water Well Record was completed on (mo/day/yr) 12/29/94 under the business name of Terracon Consultants Inc by (signature) Richard Dimmery

INSTRUCTIONS: Use typewriter or ball point pen. PLEASE PRESS FIRMLY and PRINT clearly. Please fill in blanks, underline or circle the correct answers. Send top three copies to Kansas Department of Health and Environment, Bureau of Water, Topeka, Kansas 66620-0001. Telephone: 913-296-5545. Send one to WATER WELL OWNER and retain one for your records.

OFFICE USE ONLY
T
R
EM
SEC.
1/4
1/4
1/4