


1 LOCATION OF WATER WELL: Fraction SW 1/4 SW 1/4 NW 1/4 Section Number 33 Township Number T 34 Range Number R 16  
 County: Montgomery

Distance and direction from nearest town or city street address of well if located within city?  
3806 W First St Coffeyville Ks

2 WATER WELL OWNER: Williams Pipeline  
 RR#, St. Address, Box #: 10200 W 25th Suite 270 Board of Agriculture, Division of Water Resources  
 City, State, ZIP Code: Shawnee Mission Ks 66204 Application Number:

3 LOCATE WELL'S LOCATION WITH AN "X" IN SECTION BOX:

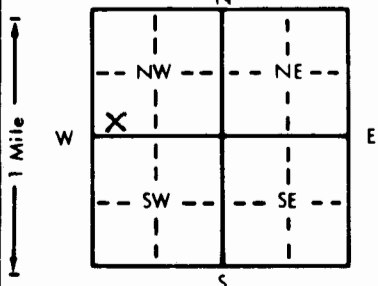

4 DEPTH OF COMPLETED WELL 13.8 ft. ELEVATION: 797.53

Depth(s) Groundwater Encountered 1. 11.64 ft. 2. — ft. 3. — ft.  
 WELL'S STATIC WATER LEVEL 11.64 ft. below land surface measured on mo/day/yr 12/7/93  
 Pump test data: Well water was — ft. after — hours pumping — gpm  
 Est. Yield — gpm: Well water was — ft. after — hours pumping — gpm  
 Bore Hole Diameter 4.5 in. to 13.8 ft., and — in. to — ft.  
 WELL WATER TO BE USED AS: 5 Public water supply 8 Air conditioning 11 Injection well  
 1 Domestic 3 Feedlot 6 Oil field water supply 9 Dewatering 12 Other (Specify below)  
 2 Irrigation 4 Industrial 7 Lawn and garden only  Monitoring well  
 Was a chemical/bacteriological sample submitted to Department? Yes — No ; If yes, mo/day/yr sample was submitted  
 Water Well Disinfected? Yes — No

5 TYPE OF BLANK CASING USED: 5 Wrought iron 8 Concrete tile CASING JOINTS: Glued — Clamped —  
 1 Steel 3 RMP (SR) 6 Asbestos-Cement 9 Other (specify below) Welded —  
 PVC 4 ABS 7 Fiberglass Threaded

Blank casing diameter 2 in. to 3.5 ft., Dia — in. to — ft., Dia — in. to — ft.  
 Casing height above land surface 0.0 in., weight Sch 40 lbs./ft. Wall thickness or gauge No. —

TYPE OF SCREEN OR PERFORATION MATERIAL:  PVC 10 Asbestos-cement  
 1 Steel 3 Stainless steel 5 Fiberglass 8 RMP (SR) 11 Other (specify) —  
 2 Brass 4 Galvanized steel 6 Concrete tile 9 ABS 12 None used (open hole)

SCREEN OR PERFORATION OPENINGS ARE: 5 Gauzed wrapped 8 Saw cut 11 None (open hole)  
 1 Continuous slot  Mill slot 6 Wire wrapped 9 Drilled holes  
 2 Louvered shutter 4 Key punched 7 Torch cut 10 Other (specify) —

SCREEN-PERFORATED INTERVALS: From — ft. to — ft., From — ft. to — ft.  
 From — ft. to — ft., From — ft. to — ft.  
 GRAVEL PACK INTERVALS: From 3.0 ft. to 13.8 ft., From — ft. to — ft.  
 From — ft. to — ft., From — ft. to — ft.

6 GROUT MATERIAL:  Neat cement 2 Cement grout  Bentonite 4 Other —  
 Grout Intervals: From 0.0 ft. to 3.0 ft., From — ft. to — ft., From — ft. to — ft.

What is the nearest source of possible contamination:  
 1 Septic tank 4 Lateral lines 7 Pit privy  Fuel storage 14 Abandoned water well  
 2 Sewer lines 5 Cess pool 8 Sewage lagoon 12 Fertilizer storage 15 Oil well/Gas well  
 3 Watertight sewer lines 6 Seepage pit 9 Feedyard 13 Insecticide storage 16 Other (specify below)

Direction from well? — How many feet? —

FROM	TO	LITHOLOGIC LOG	FROM	TO	PLUGGING INTERVALS
0.0	1.2	Topsoil DK Gr			
1.2	7.5	Sandstone Br			
7.5	12.0	Shale Gr			
12.0	13.8	Sandstone Br			

7 CONTRACTOR'S OR LANDOWNER'S CERTIFICATION: This water well was  constructed, (2) reconstructed, or (3) plugged under my jurisdiction and was completed on (mo/day/year) 10/29/93 and this record is true to the best of my knowledge and belief. Kansas Water Well Contractor's License No. 416 This Water Well Record was completed on (mo/day/yr) 2/28/94 under the business name of Terracon Consultants Inc by (signature) Richard D. ...