


RMW-107

1) LOCATION OF WATER WELL: County: Montgomery	Fraction: NW 1/4 SW 1/4 NE 1/4	Section Number: 36	Township Number: T 34 S	Range Number: R 16E EW
---	---------------------------------------	---------------------------	--------------------------------	-------------------------------

Distance and direction from nearest town or city street address of well if located within city?
COFFEYVILLE

2) WATER WELL OWNER: **FARMLAND INDUSTRIES INC**
 RR#, St. Address, Box #: **RO. BOX 570**
 City, State, ZIP Code: **COFFEYVILLE, KS 76337**
 Board of Agriculture, Division of Water Resources
 Application Number:

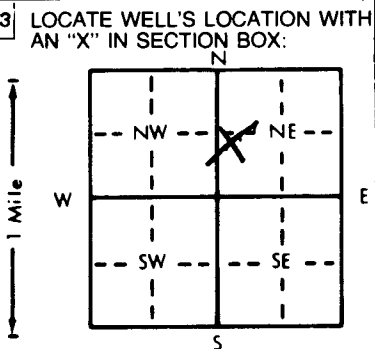

4) DEPTH OF COMPLETED WELL: **15.0** ft. ELEVATION:

Depth(s) Groundwater Encountered 1. **9.0** ft. 2. ft. 3. ft.

WELL'S STATIC WATER LEVEL ft. below land surface measured on mo/day/yr

Pump test data: Well water was ft. after hours pumping gpm

Est. Yield gpm: Well water was ft. after hours pumping gpm

Bore Hole Diameter: **8 3/4** in. to **15.0** ft., and in. to ft.

WELL WATER TO BE USED AS:

5 Public water supply	8 Air conditioning	11 Injection well
1 Domestic	3 Feedlot	6 Oil field water supply
2 Irrigation	4 Industrial	7 Lawn and garden only
		10 Monitoring well

12 Other (Specify below)

Was a chemical/bacteriological sample submitted to Department? Yes No If yes, mo/day/yr sample was submitted

Water Well Disinfected? Yes No

5) TYPE OF BLANK CASING USED:

1 Steel	3 RMP (SR)	6 Asbestos-Cement	9 Other (specify below)
2 PVC	4 ABS	7 Fiberglass	

Blank casing diameter **2** in. to **4.5** ft., Dia. in. to ft., Dia. in. to ft.

Casing height above land surface **24** in., weight lbs./ft. Wall thickness or gauge No. **Schedule 40**

CASING JOINTS: Glued Clamped
 Welded Threaded

TYPE OF SCREEN OR PERFORATION MATERIAL:

1 Steel	3 Stainless steel	5 Fiberglass	8 RMP (SR)	11 Other (specify)
2 Brass	4 Galvanized steel	6 Concrete tile	9 ABS	12 None used (open hole)

SCREEN OR PERFORATION OPENINGS ARE:

1 Continuous slot	3 Mill slot	6 Wire wrapped	9 Drilled holes
2 Louvered shutter	4 Key punched	7 Torch cut	10 Other (specify)
		8 Gauzed wrapped	11 None (open hole)

SCREEN-PERFORATED INTERVALS: From **4.5** ft. to **14.5** ft., From ft. to ft.

GRAVEL PACK INTERVALS: From **4.0** ft. to **14.5** ft., From ft. to ft.

6) GROUT MATERIAL: 1 Neat cement 2 Cement grout 3 Bentonite 4 Other

Grout Intervals: From **0.0** ft. to **2.0** ft., From **2.0** ft. to **4.0** ft., From ft. to ft.

What is the nearest source of possible contamination:

1 Septic tank	4 Lateral lines	7 Pit privy	10 Livestock pens	14 Abandoned water well
2 Sewer lines	5 Cess pool	8 Sewage lagoon	11 Fuel storage	15 Oil well/Gas well
3 Watertight sewer lines	6 Seepage pit	9 Feedyard	12 Fertilizer storage	16 Other (specify below)
			13 Insecticide storage	

Direction from well? **IN REFINERY** How many feet?

FROM	TO	LITHOLOGIC LOG	FROM	TO	PLUGGING INTERVALS
0.0	7.0	RED & BROWN SILTY CLAY -MOIST/STIFF			
7.0	10.0	RED SILTY SAND & CLAY -WET/SOFT			
10.0	12.5	BROWN SAND/GRAVEL/SILT -WET/SOFT			
12.5	15.0	RED & GRAY SHALE -DRY/HARD			

7) CONTRACTOR'S OR LANDOWNER'S CERTIFICATION: This water well was (1) constructed, (2) reconstructed, or (3) plugged under my jurisdiction and was completed on (mo/day/year) **7-7-94** and this record is true to the best of my knowledge and belief. Kansas Water Well Contractor's License No. **551** This Water Well Record was completed on (mo/day/yr) **7-22-94** under the business name of **Associated Environmental Industries** (signature)

OFFICE USE ONLY
T
R
EW
SEC.