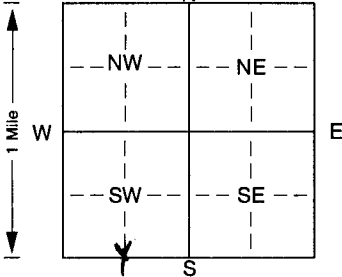


1] LOCATION OF WATER WELL: Fraction SE 1/4 SW 1/4 SW 1/4 Section Number 35 Township Number T 34 S Range Number R 16 E
 County: Montgomery

Distance and direction from nearest town or city street address of well if located within city?
703 Bellis Street, Coffeyville

2] WATER WELL OWNER: US 445
 RR#, St. Address, Box #: Box 968 Board of Agriculture, Division of Water Resources
 City, State, ZIP Code: Coffeyville, KS 67337 Application Number: MW-8

3] LOCATE WELL'S LOCATION WITH AN "X" IN SECTION BOX:  4] DEPTH OF COMPLETED WELL: 15 ft. ELEVATION:
 Depth(s) Groundwater Encountered 1. 8 ft. 2. ft. 3. ft.
 WELL'S STATIC WATER LEVEL 0 ft. below land surface measured on mo/day/yr immediate
 Pump test data: Well water was ft. after hours pumping gpm
 Est. Yield gpm: Well water was ft. after hours pumping gpm
 Bore Hole Diameter: 8 1/4 in. to ft., and in. to ft.
 WELL WATER TO BE USED AS: 5 Public water supply 8 Air conditioning 11 Injection well
 1 Domestic 3 Feedlot 6 Oil field water supply 9 Dewatering 12 Other (Specify below)
 2 Irrigation 4 Industrial 7 Domestic (lawn & garden) Monitoring well
 Was a chemical/bacteriological sample submitted to Department? Yes. No. ; If yes, mo/day/yr sample was submitted
 Water Well Disinfected? Yes No

5] TYPE OF BLANK CASING USED: 5 Wrought iron 8 Concrete tile CASING JOINTS: Glued. Clamped.
 1 Steel 3 RMP (SR) 6 Asbestos-Cement 9 Other (specify below) Welded.
 PVC 4 ABS 7 Fiberglass Threaded.
 Blank casing diameter 2 in. to 5 ft., Dia in. to ft., Dia in. to ft.
 Casing height above land surface 0 in., weight Sched. 40 lbs./ft. Wall thickness or gauge No.
 TYPE OF SCREEN OR PERFORATION MATERIAL: PVC 10 Asbestos-cement
 1 Steel 3 Stainless steel 5 Fiberglass 8 RMP (SR) 11 Other (specify)
 2 Brass 4 Galvanized steel 6 Concrete tile 9 ABS 12 None used (open hole)
 SCREEN OR PERFORATION OPENINGS ARE: 5 Gauzed wrapped 8 Saw cut 11 None (open hole)
 1 Continuous slot Mill slot 6 Wire wrapped 9 Drilled holes
 2 Louvered shutter 4 Key punched 7 Torch cut 10 Other (specify) ft.
 SCREEN-PERFORATED INTERVALS: From 5 ft. to 15 ft., From ft. to ft.
 From ft. to ft., From ft. to ft.
 GRAVEL PACK INTERVALS: From 4 ft. to 15 ft., From ft. to ft.
 From ft. to ft., From ft. to ft.

6] GROUT MATERIAL: 1 Neat cement 2 Cement grout Bentonite 4 Other
 Grout Intervals: From 0 ft. to 2 ft., From 0 ft. to 2 ft., From 4 ft. to ft.
 What is the nearest source of possible contamination:
 1 Septic tank 4 Lateral lines 7 Pit privy Fuel storage 10 Livestock pens 14 Abandoned water well
 2 Sewer lines 5 Cess pool 8 Sewage lagoon 12 Fertilizer storage 15 Oil well/Gas well
 3 Watertight sewer lines 6 Seepage pit 9 Feedyard 13 Insecticide storage 16 Other (specify below)
 Direction from well? How many feet?

FROM	TO	LITHOLOGIC LOG	FROM	TO	PLUGGING INTERVALS
<u>0</u>	<u>1.5</u>	<u>Asphalt</u>			
<u>1.5</u>	<u>2</u>	<u>Rubble</u>			
<u>2</u>	<u>15</u>	<u>Dark Gray V.S. Clay</u>			

7] CONTRACTOR'S OR LANDOWNER'S CERTIFICATION: This water well was (1) constructed, (2) reconstructed, or (3) plugged under my jurisdiction and was completed on (mo/day/year) 2/28/06 and this record is true to the best of my knowledge and belief. Kansas Water Well Contractor's Licence No. 650 This Water Well Record was completed on (mo/day/yr) 9/18/06 under the business name of D.F.S. by (signature) 