


well #1

1 LOCATION OF WATER WELL: Fraction SW 1/4 NE 1/4 SE 1/4 Section Number 29 Township Number T 34 S Range Number R 16 EW
 County: Montgomery

Distance and direction from nearest town or city street address of well if located within city?
1 mile west of 1 mile north of Coffeyville KS

2 WATER WELL OWNER: Coffeyville Country Club
 RR#, St. Address, Box #: PO Box 265 Board of Agriculture, Division of Water Resources
 City, State, ZIP Code: Coffeyville KS 67337 Application Number:

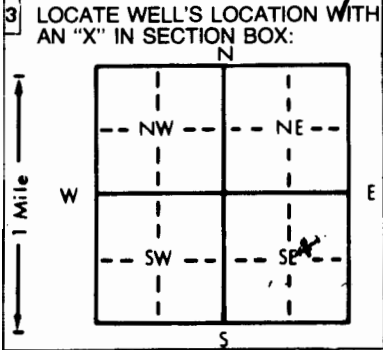

4 DEPTH OF COMPLETED WELL: 115 ft. ELEVATION:
 Depth(s) Groundwater Encountered 1. 18 ft. 2. 60 ft. 3. ft.
 WELL'S STATIC WATER LEVEL: 15 ft. below land surface measured on mo/day/yr 3/29/82
 Pump test data: Well water was ft. after hours pumping gpm
 Est. Yield gpm; Well water was ft. after hours pumping gpm
 Bore Hole Diameter: 9 3/8 in. to 20 ft., and 8 1/4 in. to 115 ft.
 WELL WATER TO BE USED AS: 5 Public water supply 8 Air conditioning 11 Injection well
 1 Domestic 3 Feedlot 6 Oil field water supply 9 Dewatering 12 Other (Specify below)
 2 Irrigation 4 Industrial 7 Lawn and garden only 10 Observation well Swimming Pool
 Was a chemical/bacteriological sample submitted to Department? Yes.....No..... If yes, mo/day/yr sample was submitted
 Water Well Disinfected? Yes No

5 TYPE OF BLANK CASING USED: 5 Wrought iron 8 Concrete tile CASING JOINTS: Glued Clamped
 1 Steel 3 RMP (SR) 6 Asbestos-Cement 9 Other (specify below) Welded
2 PVC 4 ABS 7 Fiberglass Threaded
 Blank casing diameter: 6 in. to 115 ft., Dia. in. to ft., Dia. in. to ft.
 Casing height above land surface: 14 in., weight: 31.93 lbs./ft. Wall thickness or gauge No. 0.316
 TYPE OF SCREEN OR PERFORATION MATERIAL: 7 PVC 10 Asbestos-cement
 1 Steel 3 Stainless steel 5 Fiberglass 8 RMP (SR) 11 Other (specify)
 2 Brass 4 Galvanized steel 6 Concrete tile 9 ABS 12 None used (open hole)
 SCREEN OR PERFORATION OPENINGS ARE: 5 Gauzed wrapped 8 Saw cut 11 None (open hole)
 1 Continuous slot 3 Mill slot 6 Wire wrapped 9 Drilled holes
 2 Louvered shutter 4 Key punched 7 Torch cut 10 Other (specify)
 SCREEN PERFORATED INTERVALS: 95 ft. to 115 ft., From ft. to ft.
 GRAVEL PACK INTERVALS: No gravel ft. to ft., From ft. to ft.

6 GROUT MATERIAL: 1 Neat cement 2 Cement grout 3 Bentonite 4 Other
 Grout Intervals: From 0 ft. to 14 ft., From ft. to ft., From ft. to ft.
 What is the nearest source of possible contamination: 10 Livestock pens 14 Abandoned water well
 1 Septic tank 4 Lateral lines 7 Pit privy 11 Fuel storage 15 Oil well/Gas well
 2 Sewer lines 5 Cess pool 8 Sewage lagoon 12 Fertilizer storage 16 Other (specify below)
 3 Watertight sewer lines 6 Seepage pit 9 Feedyard 13 Insecticide storage Pond
 Direction from well? South How many feet? 60'

FROM	TO	LITHOLOGIC LOG	FROM	TO	LITHOLOGIC LOG
1	2	soil			
3	6	lime rock			
7	10	shale			
11	19	sand rock			
20	29	lime rock			
30	49	shale			
49	50	lime rock			
51	93	shale			
94	115	lime rock			

7 CONTRACTOR'S OR LANDOWNER'S CERTIFICATION: This water well was (1) constructed, (2) reconstructed, or (3) plugged under my jurisdiction and was completed on (mo/day/year) 3/29/82 and this record is true to the best of my knowledge and belief. Kansas Water Well Contractor's License No. 424 This Water Well Record was completed on (mo/day/yr) 4/19/82 under the business name of Prarie Drilling by (signature) [Signature]

INSTRUCTIONS: Use typewriter or ball point pen, PLEASE PRESS FIRMLY and PRINT clearly. Please fill in blanks, underline or circle the correct answers. Send top three copies to Kansas Department of Health and Environment, Division of Environment, Environmental Geology Section, Topeka, KS 66620. Send one to WATER WELL OWNER and retain one for your records.

OFFICE USE ONLY
T 34 S R 16 EW
SEC. 29 SW 1/4 NE 1/4 SE 1/4