


well # 2

1 LOCATION OF WATER WELL: Fraction NW 1/4 SE 1/4 SE 1/4 Section Number 29 Township Number T 34 S Range Number R 16 E/W

Distance and direction from nearest town or city street address of well if located within city? 1 mile west + 1 mile north of Coffeyville Kansas

2 WATER WELL OWNER: Coffeyville Country Club RR#, St. Address, Box #: PO Box 265 City, State, ZIP Code: Coffeyville KS 67337 Board of Agriculture, Division of Water Resources Application Number:

3 LOCATE WELL'S LOCATION WITH AN "X" IN SECTION BOX:

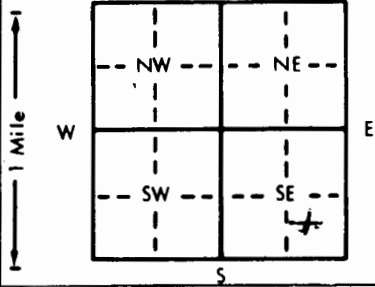

4 DEPTH OF COMPLETED WELL: 11.5 ft. ELEVATION: Depth(s) Groundwater Encountered 1. 2.4 ft. 2. 75 ft. 3. WELL'S STATIC WATER LEVEL: 14 ft. below land surface measured on mo/day/yr 4/3/82

Pump test data: Well water was ... ft. after ... hours pumping ... gpm Est. Yield ... gpm: Well water was ... ft. after ... hours pumping ... gpm Bore Hole Diameter ... in. to ... ft., and ... in. to ... ft. WELL WATER TO BE USED AS: 5 Public water supply 8 Air conditioning 11 Injection well 1 Domestic 3 Feedlot 6 Oil field water supply 9 Dewatering 12 Other (Specify below) 2 Irrigation 4 Industrial 7 Lawn and garden only 10 Observation well swimming pool Was a chemical/bacteriological sample submitted to Department? Yes No; If yes, mo/day/yr sample was submitted Water Well Disinfected? Yes No

5 TYPE OF BLANK CASING USED: 1 Steel 2 PVC 3 RMP (SR) 4 ABS 5 Wrought iron 6 Asbestos-Cement 7 Fiberglass 8 Concrete tile 9 Other (specify below) CASING JOINTS: Glued Clamped Welded Threaded

Blank casing diameter: 4 in. to 11.5 ft., Dia 3.93 in. to 0.316 ft. Casing height above land surface: 14 in., weight 3.93 lbs./ft. Wall thickness or gauge No. 0.316

TYPE OF SCREEN OR PERFORATION MATERIAL: 1 Steel 2 Brass 3 Stainless steel 4 Galvanized steel 5 Fiberglass 6 Concrete tile 7 PVC 8 RMP (SR) 9 ABS 10 Asbestos-cement 11 Other (specify) 12 None used (open hole)

SCREEN OR PERFORATION OPENINGS ARE: 1 Continuous slot 2 Louvered shutter 3 Mill slot 4 Key punched 5 Gauzed wrapped 6 Wire wrapped 7 Torch cut 8 Saw cut 9 Drilled holes 10 Other (specify) 11 None (open hole)

SCREEN PERFORATED INTERVALS: From 9.5 ft. to 11.5 ft. GRAVEL PACK INTERVALS: From no gravel pack ft. to ft.

6 GROUT MATERIAL: Neat cement 2 Cement grout 3 Bentonite 4 Other Grout intervals: From 1 ft. to 1.4 ft.

What is the nearest source of possible contamination: 1 Septic tank 2 Sewer lines 3 Watertight sewer lines 4 Lateral lines 5 Cess pool 6 Seepage pit 7 Pit privy 8 Sewage lagoon 9 Feedyard 10 Livestock pens 11 Fuel storage 12 Fertilizer storage 13 Insecticide storage 14 Abandoned water well 15 Oil well/Gas well 16 Other (specify below) creek How many feet? 80

Table with columns FROM, TO, LITHOLOGIC LOG. Rows show depth intervals and lithology: 1-4 soil, 5-9 lime, 9-11 shale, 12-19 sandstn., 20-29 lime, 30-50 slab, 51-53 lime, 54-90 shale, 91-110 lime, 111-115 shale.

7 CONTRACTOR'S OR LANDOWNER'S CERTIFICATION: This water well was (1) constructed, (2) reconstructed, or (3) plugged under my jurisdiction and was completed on (mo/day/year) 4/3/82 and this record is true to the best of my knowledge and belief. Kansas Water Well Contractor's License No. 408 This Water Well Record was completed on (mo/day/yr) 4/21/82 under the business name of Prairie Drilling Co. by (signature) Taylor, Michael

INSTRUCTIONS: Use typewriter or ball point pen, PLEASE PRESS FIRMLY and PRINT clearly. Please fill in blanks, underline or circle the correct answers. Send top three copies to Kansas Department of Health and Environment, Division of Environment, Environmental Geology Section, Topeka, KS 66620. Send one to WATER WELL OWNER and retain one for your records.

OFFICE USE ONLY T 34 R 16 SW 29 NW 1/4 SE 1/4 SE 1/4