


NW-2

1 LOCATION OF WATER WELL: Fraction SW 1/4 NE 1/4 SE 1/4 Section Number 34 Township Number T 34 S Range Number R 16 EW
 County: Montgomery
 Distance and direction from nearest town or city street address of well if located within city? 1604 W 4th Street

2 WATER WELL OWNER: Fred Oliver
 RR#, St. Address, Box #: PO Box 1014 Coffeyville, KS 67337
 City, State, ZIP Code: Coffeyville, KS 67337
 Board of Agriculture, Division of Water Resources
 Application Number:

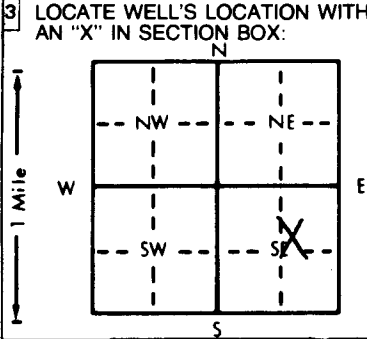

4 DEPTH OF COMPLETED WELL: 16 ft. ELEVATION: NA
 Depth(s) Groundwater Encountered 1. 4.85 ft. 2. NA ft. 3. NA ft.
 WELL'S STATIC WATER LEVEL 4.85 ft. below land surface measured on mo/day/yr 8/18/98
 Pump test data: Well water was NA ft. after NA hours pumping NA gpm
 Est. Yield NA gpm: Well water was NA ft. after NA hours pumping NA gpm
 Bore Hole Diameter 8.625 in. to 16 ft., and NA in. to NA ft.
 WELL WATER TO BE USED AS: 5 Public water supply 8 Air conditioning 11 Injection well
 1 Domestic 3 Feedlot 6 Oil field water supply 9 Dewatering 12 Other (Specify below)
 2 Irrigation 4 Industrial 7 Lawn and garden only Monitoring well NW-2
 Was a chemical/bacteriological sample submitted to Department? Yes NA No X; If yes, mo/day/yr sample was submitted
 Water Well Disinfected? Yes NA No X

5 TYPE OF BLANK CASING USED: 1 Steel 3 RMP (SR) 5 Wrought iron 8 Concrete tile CASING JOINTS: Glued NA Clamped NA
 2 PVC 4 ABS 6 Asbestos-Cement 9 Other (specify below) Welded NA
 7 Fiberglass Threaded X
 Blank casing diameter 2 in. to 6 ft., Dia. NA in. to NA ft., Dia. NA in. to NA ft.
 Casing height above land surface Flush in., weight SCH40 lbs./ft. Wall thickness or gauge No. NA
 TYPE OF SCREEN OR PERFORATION MATERIAL: PVC 10 Asbestos-cement
 1 Steel 3 Stainless steel 5 Fiberglass 8 RMP (SR) 11 Other (specify) NA
 2 Brass 4 Galvanized steel 6 Concrete tile 9 ABS 12 None used (open hole)
 SCREEN OR PERFORATION OPENINGS ARE: 5 Gauzed wrapped 8 Saw cut 11 None (open hole)
 1 Continuous slot Mill slot 6 Wire wrapped 9 Drilled holes
 2 Louvered shutter 4 Key punched 7 Torch cut 10 Other (specify) NA
 SCREEN-PERFORATED INTERVALS: From 6 ft. to 16 ft., From NA ft. to NA ft.
 From NA ft. to NA ft., From NA ft. to NA ft.
 GRAVEL PACK INTERVALS: From 5 ft. to 16 ft., From NA ft. to NA ft.
 From NA ft. to NA ft., From NA ft. to NA ft.

6 GROUT MATERIAL: 1 Neat cement 2 Cement grout 3 Bentonite 4 Other NA
 Grout Intervals: 3 From 3 ft. to 5 ft. 2 From 3 ft. to 0 ft., From NA ft. to NA ft.
 What is the nearest source of possible contamination:
 1 Septic tank 4 Lateral lines 7 Pit privy 10 Livestock pens 14 Abandoned water well
 2 Sewer lines 5 Cess pool 8 Sewage lagoon 11 Fuel storage 15 Oil well/Gas well
 3 Watertight sewer lines 6 Seepage pit 9 Feedyard 12 Fertilizer storage 16 Other (specify below)
Contaminated site
 Direction from well? How many feet? NA

| FROM | TO | LITHOLOGIC LOG | FROM | TO | PLUGGING INTERVALS |
|------|-----|-------------------|------|----|--------------------|
| 0 | 6" | Asphalt | | | |
| 6" | 1' | Fill mat. | | | |
| 1' | 16' | Clay w/ some silt | | | |
| 16' | TD | end of borehole | | | |

7 CONTRACTOR'S OR LANDOWNER'S CERTIFICATION: This water well was 1 constructed, (2) reconstructed, or (3) plugged under my jurisdiction and was completed on (mo/day/year) 8/18/98 and this record is true to the best of my knowledge and belief. Kansas Water Well Contractor's License No. AEI 585 This Water Well Record was completed on (mo/day/yr) 8/20/98 under the business name of AEI by (signature) Stanley D. Duncan

INSTRUCTIONS: Use typewriter or ball point pen. PLEASE PRESS FIRMLY and PRINT clearly. Please fill in blanks, underline or circle the correct answers. Send two three copies to Kansas Department of Health and Environment, Bureau of Water, Topeka, Kansas 66620-0001. Telephone: 913-296-5545. Send one to WATER WELL OWNER and retain one for your records.

OFFICE USE ONLY
T
R
EW
SEC.