


1 LOCATION OF WATER WELL: Fraction SE 1/4 SW 1/4 SW 1/4 Section Number 35 Township Number T 34 S Range Number R 16 EW  
 County: Montgomery

Distance and direction from nearest town or city street address of well if located within city?  
703 Ellis Street Coffeyville, KS

2 WATER WELL OWNER: USD 445 MW 05  
 RR#, St. Address, Box #: 703 Ellis Board of Agriculture, Division of Water Resources  
 City, State, ZIP Code: Coffeyville Application Number:

3 LOCATE WELL'S LOCATION WITH AN "X" IN SECTION BOX:  
 4 DEPTH OF COMPLETED WELL: 15 ft. ELEVATION: ~~750.99~~ 750.99  
 Depth(s) Groundwater Encountered 1. 3.88 ft. 2. 3.88 ft. 3. 8/20/97 ft.

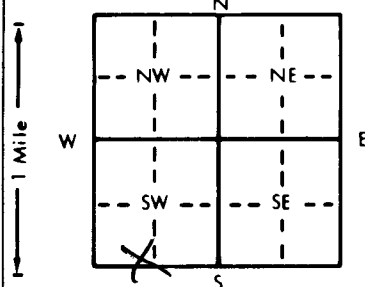

WELL'S STATIC WATER LEVEL 3.88 ft. below land surface measured on mo/day/yr 8/20/97  

WELL WATER TO BE USED AS:  
 1 Domestic  2 Irrigation  3 Feedlot  4 Industrial  5 Public water supply  6 Oil field water supply  7 Lawn and garden only  8 Air conditioning  9 Dewatering  10 Monitoring well  11 Injection well  12 Other (Specify below)

Was a chemical/bacteriological sample submitted to Department? Yes  No  If yes, mo/day/yr sample was submitted 8/20/97  
 Water Well Disinfected? Yes  No

5 TYPE OF CASING USED:  
 1 Steel  2 PVC 3 RMP (SR)  4 ABS  5 Wrought iron  6 Asbestos-Cement  7 Fiberglass  8 Concrete tile  9 Other (specify below)  CASING JOINTS: Glued  Clamped   
 Casing height above land surface 0 in., weight 0 lbs./ft. Wall thickness or gauge No. 0  
 TYPE OF SCREEN OR PERFORATION MATERIAL:  
 1 Steel  2 Brass  3 Stainless steel  4 Galvanized steel  5 Fiberglass  6 Concrete tile  7 PVC  8 RMP (SR)  9 ABS  10 Asbestos-cement  11 Other (specify)  12 None used (open hole)   
 SCREEN OR PERFORATION OPENINGS ARE:  
 1 Continuous slot  2 Louvered shutter  3 Mill slot  4 Key punched  5 Gauzed wrapped  6 Wire wrapped  7 Torch cut  8 Saw cut  9 Drilled holes  10 Other (specify)  11 None (open hole)   

6 GROUT MATERIAL: 1 Neat cement  2 Cement grout  3 Bentonite  4 Other   
 What is the nearest source of possible contamination:  
 1 Septic tank  2 Sewer lines  3 Watertight sewer lines  4 Lateral lines  5 Cess pool  6 Seepage pit  7 Pit privy  8 Sewage lagoon  9 Feedyard  10 Livestock pens  11 Fuel storage  12 Fertilizer storage  13 Insecticide storage  14 Abandoned water well  15 Oil well/Gas well  16 Other (specify below)  UST  
 Direction from well? UST  
 How many feet? UST

FROM	TO	LITHOLOGIC LOG	FROM	TO	PLUGGING INTERVALS
<u>0</u>	<u>1</u>	<u>Topsoil, Black, organic</u>			
<u>1</u>	<u>4.5</u>	<u>Clay, DK. Brown w/ fine sand</u>			
<u>4.5</u>	<u>12</u>	<u>Clay, Red Brown w/ fine sand</u>			
<u>12</u>	<u>15</u>	<u>Silt, Brown w/ some clay</u>			

Flush mount lower  
by P. Taylor

7 CONTRACTOR'S OR LANDOWNER'S CERTIFICATION: This water well was (1) constructed, (2) reconstructed, or (3) plugged under my jurisdiction and was completed on (mo/day/year) 8/14/97 and this record is true to the best of my knowledge and belief. Kansas Water Well Contractor's License No. 483 This Water Well Record was completed on (mo/day/yr) 10/31/97 under the business name of T.E.S.T. by (signature) Ed Robinson by LL

OFFICE USE ONLY  
T  
R  
EW  
SEC.  
1/4  
1/4  
1/4