MW2

WATER WELL RECORD Form WWC-5 KSA 82a-1212

1 LOCATION OF WATER WELL: County: Montgomery | Fraction: SW ¼ SE ¼ SE ¼ | Section Number: 36 | Township Number: T 34 S | Range Number: R 16 (E) W

Distance and direction from nearest town or city street address of well if located within city?
620 E 8TH STREET, COFFEYVILLE, KS

2 WATER WELL OWNER: EDDY'S ONE STOP
RR#, St. Address, Box # : 302 N OHIO
City, State, ZIP Code : COFFEYVILLE, KS 67337

Board of Agriculture, Division of Water Resources Application Number: —

3 LOCATE WELL'S LOCATION WITH AN "X" IN SECTION BOX:

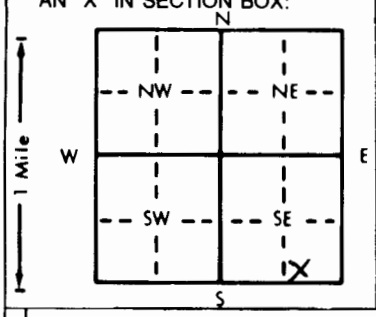

4 DEPTH OF COMPLETED WELL 20.5 ft. ELEVATION: —
Depth(s) Groundwater Encountered 1. ~15 ft. 2. — ft. 3. — ft.
WELL'S STATIC WATER LEVEL 6.74 ft. below land surface measured on mo/day/yr 4/15/98
Pump test data: Well water was — ft. after — hours pumping — gpm
Est. Yield — gpm: Well water was — ft. after — hours pumping — gpm
Bore Hole Diameter 8.5 in. to 20.5 ft., and — in. to — ft.
WELL WATER TO BE USED AS: 1 Domestic 2 Irrigation 3 Feedlot 4 Industrial 5 Public water supply 6 Oil field water supply 7 Lawn and garden only 8 Air conditioning 9 Dewatering (10) Monitoring well 11 Injection well 12 Other (Specify below) MW2
Was a chemical/bacteriological sample submitted to Department? Yes — No X; If yes, mo/day/yr sample was submitted
Water Well Disinfected? Yes — No X

5 TYPE OF BLANK CASING USED: 1 Steel (2) PVC 3 RMP (SR) 4 ABS 5 Wrought iron 6 Asbestos-Cement 7 Fiberglass 8 Concrete tile 9 Other (specify below)
CASING JOINTS: Glued — Clamped — Welded — Threaded X
Blank casing diameter 2" in. to 10.5 ft., Dia — in. to — ft., Dia — in. to — ft.
Casing height above land surface 0 in., weight SH 40 lbs./ft. Wall thickness or gauge No. —
TYPE OF SCREEN OR PERFORATION MATERIAL: 1 Steel 2 Brass 3 Stainless steel 4 Galvanized steel 5 Fiberglass 6 Concrete tile (7) PVC 8 RMP (SR) 9 ABS 10 Asbestos-cement 11 Other (specify) 12 None used (open hole)
SCREEN OR PERFORATION OPENINGS ARE: 1 Continuous slot 2 Louvered shutter (3) Mill slot 4 Key punched 5 Gauzed wrapped 6 Wire wrapped 7 Torch cut 8 Saw cut 9 Drilled holes 10 Other (specify) 11 None (open hole)
SCREEN-PERFORATED INTERVALS: From 10.5 ft. to 20.5 ft., From — ft. to — ft.
From — ft. to — ft., From — ft. to — ft.
SAND GRAVEL PACK INTERVALS: From 9 ft. to 20.5 ft., From — ft. to — ft.
From — ft. to — ft., From — ft. to — ft.

6 GROUT MATERIAL: 1 Neat cement (2) Cement grout (3) Bentonite 4 Other —
Grout Intervals: From 0 ft. to 7 ft., From 7 ft. to 9 ft., From — ft. to — ft.
What is the nearest source of possible contamination: 1 Septic tank 2 Sewer lines 3 Watertight sewer lines 4 Lateral lines 5 Cess pool 6 Seepage pit 7 Pit privy 8 Sewage lagoon 9 Feedyard 10 Livestock pens 11 Fuel storage 12 Fertilizer storage 13 Insecticide storage 14 Abandoned water well 15 Oil well/Gas well 16 Other (specify below) Contaminated site
Direction from well? How many feet? —

FROM	TO	LITHOLOGIC LOG	FROM	TO	PLUGGING INTERVALS
0	.5	CONCRETE			
.5	13.5	CLAY W/ SOME SILT (CL)			
13.5	15	SILT W/ SOME CLAY (ML)			
15	20.5	SILTY SAND (SP)			

7 CONTRACTOR'S OR LANDOWNER'S CERTIFICATION: This water well was (1) constructed, (2) reconstructed, or (3) plugged under my jurisdiction and was completed on (mo/day/year) 4/13/98 and this record is true to the best of my knowledge and belief. Kansas Water Well Contractor's License No. 585 This Water Well Record was completed on (mo/day/yr) 4/14/98 under the business name of AEI by (signature) A Duncan for M. Drake

INSTRUCTIONS: Use typewriter or ball point pen. *PLEASE PRESS FIRMLY* and *PRINT* clearly. Please fill in blanks, underline or circle the correct answers. Send top three copies to Kansas Department of Health and Environment, Bureau of Water, Topeka, Kansas 66620-0001. Telephone: 913-296-5545. Send one to WATER WELL OWNER and retain one for your records.

OFFICE USE ONLY T R E/W SEC. ¼ ¼ ¼