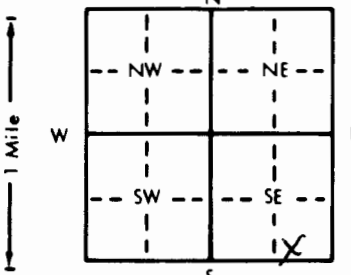


NW-6

1 LOCATION OF WATER WELL: Fraction SW 1/4 SE 1/4 SE 1/4 Section Number 36 Township Number T 34 S Range Number R 16 EW
 County: MONTGOMERY

Distance and direction from nearest town or city street address of well if located within city?
620 E 8TH STREET, COFFEYVILLE, KS

2 WATER WELL OWNER: EDDY'S ONE STOP
 RR#, St. Address, Box #: 302 N OHIO Board of Agriculture, Division of Water Resources
 City, State, ZIP Code: COFFEYVILLE, KS 67337 Application Number:

3 LOCATE WELL'S LOCATION WITH AN "X" IN SECTION BOX:

 4 DEPTH OF COMPLETED WELL: 20.5 ft. ELEVATION:
 Depth(s) Groundwater Encountered 1. ~14.5 ft. 2. ft. 3. ft.
 WELL'S STATIC WATER LEVEL: 5.82 ft. below land surface measured on mo/day/yr 4/15/98
 Pump test data: Well water was ft. after hours pumping gpm
 Est. Yield gpm: Well water was ft. after hours pumping gpm
 Bore Hole Diameter: 8.5 in. to 20.5 ft., and in. to ft.
 WELL WATER TO BE USED AS:
 1 Domestic 3 Feedlot 6 Oil field water supply 9 Dewatering 12 Other (Specify below)
 2 Irrigation 4 Industrial 7 Lawn and garden only 10 Monitoring well MW-6
 Was a chemical/bacteriological sample submitted to Department? Yes No X; If yes, mo/day/yr sample was submitted
 Water Well Disinfected? Yes No X

5 TYPE OF BLANK CASING USED:
 1 Steel 3 RMP (SR) 5 Wrought iron 8 Concrete tile CASING JOINTS: Glued Clamped
2 PVC 4 ABS 6 Asbestos-Cement 9 Other (specify below) Welded
 7 Fiberglass Threaded X
 Blank casing diameter: 2" in. to 10.5 ft. Dia. in. to ft. Dia. in. to ft.
 Casing height above land surface: 0 in., weight SCH 40 lbs./ft. Wall thickness or gauge No.
 TYPE OF SCREEN OR PERFORATION MATERIAL:
 1 Steel 3 Stainless steel 5 Fiberglass 7 PVC 10 Asbestos-cement
 2 Brass 4 Galvanized steel 6 Concrete tile 8 RMP (SR) 11 Other (specify)
 9 ABS 12 None used (open hole)
 SCREEN OR PERFORATION OPENINGS ARE:
 1 Continuous slot 3 Mill slot 5 Gauzed wrapped 8 Saw cut 11 None (open hole)
 2 Louvered shutter 4 Key punched 6 Wire wrapped 9 Drilled holes
 7 Torch cut 10 Other (specify)
 SCREEN-PERFORATED INTERVALS: From 10.5 ft. to 20.5 ft., From ft. to ft.
 From ft. to ft., From ft. to ft.
 SAND GRAVEL PACK INTERVALS: From 9 ft. to 20.5 ft., From ft. to ft.
 From ft. to ft., From ft. to ft.

6 GROUT MATERIAL: 1 Neat cement 2 Cement grout 3 Bentonite 4 Other
 Grout Intervals: 2 From 0 ft. to 7 ft., From 3 ft. to 7 ft., From 9 ft. to ft.
 What is the nearest source of possible contamination:
 1 Septic tank 4 Lateral lines 7 Pit privy 10 Livestock pens 14 Abandoned water well
 2 Sewer lines 5 Cess pool 8 Sewage lagoon 11 Fuel storage 15 Oil well/Gas well
 3 Watertight sewer lines 6 Seepage pit 9 Feedyard 12 Fertilizer storage 16 Other (specify below) contaminated site
 13 Insecticide storage
 Direction from well? How many feet?

FROM	TO	LITHOLOGIC LOG	FROM	TO	PLUGGING INTERVALS
0	1	Gravel/Fill Dirt			
1	8	CLAY w/ SOME SILT (CL)			
8	13.5	RUBBLE			
13.5	20.5	CLAYEY SILT (ML)			
8	13.5	CLAYEY SILT (ML)			
13.5	13.5	RUBBLE			
13.5	20.5	SANDY SILT			

7 CONTRACTOR'S OR LANDOWNER'S CERTIFICATION: This water well was 1 constructed, (2) reconstructed, or (3) plugged under my jurisdiction and was completed on (mo/day/year) 4/14/98 and this record is true to the best of my knowledge and belief. Kansas Water Well Contractor's License No. 585 This Water Well Record was completed on (mo/day/yr) 4/17/98 under the business name of PEI by (signature) Aduncan for M. Drake

OFFICE USE ONLY
T
R
EW
SEC