


MW9 ~~16 EW~~

1 LOCATION OF WATER WELL: Fraction SW 1/4 SE 1/4 SE 1/4 Section Number 36 Township Number T 34 S Range Number R 16 EW  
 County: MONTGOMERY

Distance and direction from nearest town or city street address of well if located within city?  
620 E 8TH STREET, COFFEYVILLE, KS

2 WATER WELL OWNER: EDDYS ONE STOP  
 RR#, St. Address, Box #: 302 N. DHTD Board of Agriculture, Division of Water Resources  
 City, State, ZIP Code: COFFEYVILLE KS 67337 Application Number: —

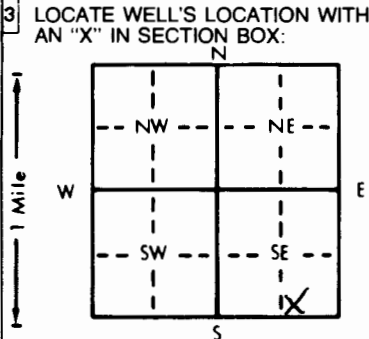

4 DEPTH OF COMPLETED WELL: 20.5 ft. ELEVATION: —  
 Depth(s) Groundwater Encountered 1. ~15 ft. 2. — ft. 3. — ft.  
 WELL'S STATIC WATER LEVEL: 6.34 ft. below land surface measured on mo/day/yr 4/15/98  
 Pump test data: Well water was — ft. after — hours pumping — gpm  
 Est. Yield — gpm Well water was — ft. after — hours pumping — gpm  
 Bore Hole Diameter: 8.5 in. to 20.5 ft., and — in. to — ft.  
 WELL WATER TO BE USED AS:  
 1 Domestic 3 Feedlot 6 Oil field water supply 9 Dewatering 12 Other (Specify below)  
 2 Irrigation 4 Industrial 7 Lawn and garden only 10 Monitoring well MW9  
 Was a chemical/bacteriological sample submitted to Department? Yes — No X; If yes, mo/day/yr sample was submitted  
 Water Well Disinfected? Yes — No X

5 TYPE OF BLANK CASING USED:  
 1 Steel 3 RMP (SR) 5 Wrought iron 8 Concrete tile CASING JOINTS: Glued — Clamped —  
2 PVC 4 ABS 6 Asbestos-Cement 9 Other (specify below) Welded —  
 7 Fiberglass Threaded X  
 Blank casing diameter 2 in. to 20.5 ft. Dia — in. to — ft. Dia — in. to — ft.  
 Casing height above land surface 0 in. weight SCH 40 lbs./ft. Wall thickness or gauge No. —  
 TYPE OF SCREEN OR PERFORATION MATERIAL:  
 1 Steel 3 Stainless steel 5 Fiberglass 8 RMP (SR) 10 Asbestos-cement  
 2 Brass 4 Galvanized steel 6 Concrete tile 9 ABS 11 Other (specify) —  
 12 None used (open hole)  
 SCREEN OR PERFORATION OPENINGS ARE:  
 1 Continuous slot 3 Mill slot 5 Gauzed wrapped 8 Saw cut 11 None (open hole)  
2 Louvered shutter 4 Key punched 6 Wire wrapped 9 Drilled holes  
 7 Torch cut 10 Other (specify) —  
 SCREEN-PERFORATED INTERVALS: From 10.5 ft. to 20.5 ft. From — ft. to — ft.  
 From — ft. to — ft. From — ft. to — ft.  
 GRAVEL PACK INTERVALS: From 9 ft. to 20.5 ft. From — ft. to — ft.  
 From — ft. to — ft. From — ft. to — ft.

6 GROUT MATERIAL: 1 Neat cement 2 Cement grout 3 Bentonite 4 Other —  
 Grout Intervals: From 0 ft. to 7 ft. From 7 ft. to 9 ft. From — ft. to — ft.  
 What is the nearest source of possible contamination:  
 1 Septic tank 4 Lateral lines 7 Pit privy 10 Livestock pens 14 Abandoned water well  
 2 Sewer lines 5 Cess pool 8 Sewage lagoon 11 Fuel storage 15 Oil well/Gas well  
 3 Watertight sewer lines 6 Seepage pit 9 Feedyard 12 Fertilizer storage 16 Other (specify below)  
contaminated site  
 Direction from well? How many feet?

FROM	TO	LITHOLOGIC LOG	FROM	TO	PLUGGING INTERVALS
0	1	SOIL			
1	14	CLAY w/ SOME SILT (CL)			
14	20.5	CLAY SILT (ML)			
20.5	TD	END OF BORE HOLE			

7 CONTRACTOR'S OR LANDOWNER'S CERTIFICATION: This water well was 1 constructed, (2) reconstructed, or (3) plugged under my jurisdiction and was completed on (mo/day/year) 4/15/98 and this record is true to the best of my knowledge and belief. Kansas Water Well Contractor's License No. 585 This Water Well Record was completed on (mo/day/yr) 4/17/98 under the business name of AEJ by (signature) Adrian A. M. Drah

OFFICE USE ONLY  
T  
R  
EW  
SEC.  
1/4  
1/4  
1/4