

County: Montgomery Fraction NW NW NW SE Sec. 36 T 34 S R 16 (E/W)

CORRECTION(S) TO WATER WELL COMPLETION RECORD (WWC-5)

(to rectify lacking or incorrect information)

Owner: Coffeyville Resources LLC

Location was listed as:

Section-Township-Range: None Given

Fraction (1/4 1/4 1/4): _____

Location changed to:

36 - 34 S - 16 E

NW NW NW SE

Other changes: Initial statements: _____

Changed to: _____

Comments: _____

Verification method: Latitude & Longitude, KGS' "LEO" conversion tool, wellsite address, city street map, and mapping tool on KGS website. initials: ARL date: 7/2/2013


Submitted by: Kansas Geological Survey, Data Resources Library, 1930 Constant Ave., Lawrence, KS 66047-3726

to: Kansas Dept of Health & Environment, Bureau of Water, 1000 SW Jackson, Suite 420, Topeka, KS 66612-1367.

1	LOCATION OF WATER WELL:	Fraction ¼ ¼ ¼	Section	Number	Township	Number	Range	Number	
County: <u>MONTGOMERY</u>		E/W							

Distance and direction from nearest town or city street address of well if located within city? Ground ELEV.
1st - Sycamore Coffeyville KS LAT: 37° 02' 35.35" LONG: 95° 36' 37.72 730.89

2	WATER WELL OWNER: <u>COFFEYVILLE RESOURCES LLC</u> <u>CVR Energy Inc</u>	Contact: <u>Brent Smith - for owner.</u>
RR #, St. Address, Box #: <u>400 N. Linden St.</u>		Board of Agriculture, Division of Water Resources
City, State, ZIP Code : <u>Coffeyville KS 67337</u>		Application Number:

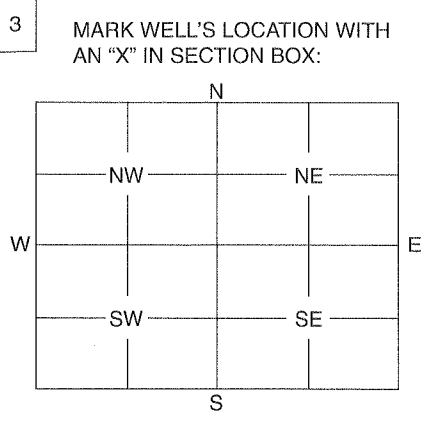

4 DEPTH OF WELL 12 ft.

WELL'S STATIC WATER LEVEL 11 1/2 ft.

WELL WAS USED AS:

<input checked="" type="checkbox"/> 1 Domestic	5 Public Water Supply	9 Dewatering
2 Irrigation	6 Oil Field Water Supply	10 Monitoring Well
3 Feedlot	7 Domestic (Lawn & Garden)	11 Injection Well
4 Industrial	8 Air Conditioning	12 Other

Was a chemical / bacteriological sample submitted to Department? Yes No

If yes, mo/day/yr sample was submitted

Water Well Disinfected: Yes No

10% Liquid chlorine added

5 TYPE OF BLANK CASING USED:

1 Steel	3 RMP (SR)	5 Wrought	7 Fiberglass	<input checked="" type="checkbox"/> 9 Other (Specify below)
2 PVC	4 ABS	6 Asbestos-Cement	8 Concrete Tile	<u>HAND DUG - ROCK WALL</u>

Blank casing diameter in. Was casing pulled? Yes No If yes, how much

Casing height above or below land surface in.

6 GROUT PLUG MATERIAL: 1 Neat cement 2 Cement grout 3 Bentonite 4 Other

Grout Plug Intervals: From 6' ft. to 3' ft., From ft. to ft., From to ft.

What is the nearest source of possible contamination:

1 Septic tank	6 Seepage pit	11 Fuel storage	16 Other (specify below)
2 Sewer lines	7 Pit privy	12 Fertilizer storage
3 Watertight sewer lines	8 Sewage lagoon	13 Insecticide storage	
4 Lateral lines	9 Feedyard	14 Abandoned water well	
5 Cess pool	10 Livestock pens	15 Oil well/Gas well	

Direction from well? How many feet?

FROM	TO	PLUGGING MATERIALS
<u>12'</u>	<u>9'</u>	<u>GRAVEL + SAND</u>
<u>9'</u>	<u>6'</u>	<u>CLAY</u>
<u>6'</u>	<u>3'</u>	<u>CEMENT GROUT</u>
<u>3'</u>	<u>0'</u>	<u>CLAY CAPPED WITH TOPSOIL</u>

7 CONTRACTOR'S OF LANDOWNER'S CERTIFICATION: This water well was plugged under my jurisdiction and was completed on (mo/day/year) 01/25/2013 and this record is true to the best of my knowledge and belief. Kansas Water Well Contractor's License No. This Water Well Record was completed on (mo/day/year) 01/25/2013 under the business name of Muller Construction Inc. by (signature) Jac. Muller

INSTRUCTIONS: Use typewriter or ball point pen. Please press firmly and print clearly. Please fill in blanks, underline or circle the correct answers. Send top three copies to Kansas Department of Health and Environment, Bureau of Water, Geology Section, 1000 SW Jackson St., Ste. 420, Topeka, Kansas 66612-1367. Telephone: 785/296-5522. Send one to Water Well Owner and retain one for your records.

PLUGGING of a DUG WELL

BEFORE

AFTER

