


1 LOCATION OF WATER WELL: Fraction NW 1/4 NW 1/4 NW 1/4 Section Number 19 Township Number 34 Range Number 16  W  
 County: MONTGOMERY

Distance and direction from nearest town or city street address of well if located within city?  
1.25 MILES north of Pearing Kansas along BR 3900, thence east on CR 2400 approximately 0.1 mile on south side.

2 WATER WELL OWNER: HELEN HALL  
 RR#, St. Address, Box #: 3920 CR 2400  
 City, State ZIP Code: COFFEYVILLE, KANSAS 67337  
 Global Positioning Systems (decimal degrees, min. of 4 digits)  
 Latitude: \_\_\_\_\_  
 Longitude: \_\_\_\_\_  
 Elevation: \_\_\_\_\_  
 Datum: \_\_\_\_\_  
 Data Collection Method: \_\_\_\_\_

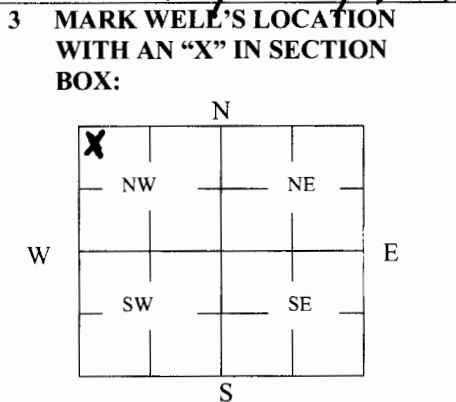

4 DEPTH OF WELL 58 ft.  
 WELL'S STATIC WATER LEVEL 25 ft.  
 WELL WAS USED AS:  
 Domestic      5 Public Water Supply      9 Dewatering  
 2 Irrigation      6 Oil Field Water Supply      10 Monitoring  
 3 Feedlot      7 Domestic (Lawn & Garden)      11 Injection Well  
 4 Industrial      8 Air Conditioning      12 Other \_\_\_\_\_  
 Was a chemical/bacteriological sample submitted to Department? Yes \_\_\_\_\_ No

5 TYPE OF BLANK CASING USED:  
 Steel      3 RMP (SR)      5 Wrought      7 Fiberglass      9 Other (Specify below) \_\_\_\_\_  
 2 PVC      4 ABS      6 Asbestos-Cement      8 Concrete Tile \_\_\_\_\_  
 Blank casing diameter 8 in. Was casing pulled? Yes  No \_\_\_\_\_ If yes, how much 36 INCHES  
 Casing height above or below land surface 36 in.

6 GROUT PLUG MATERIAL:  Neat cement      2 Cement grout      3 Bentonite      4 Other \_\_\_\_\_  
 Grout Plug Intervals: From 27 ft. to 3 ft., From \_\_\_\_\_ ft. to \_\_\_\_\_ ft., From \_\_\_\_\_ to \_\_\_\_\_ ft.  
 What is the nearest source of possible contamination:  
 Septic tank      6 Seepage pit      11 Fuel Storage      16 Other (specify below) \_\_\_\_\_  
 2 Sewer lines      7 Pit privy      12 Fertilizer storage \_\_\_\_\_  
 3 Watertight sewer lines      8 Sewage lagoon      13 Insecticide storage \_\_\_\_\_  
 4 Lateral lines      9 Feedyard      14 Abandoned water well      Direction from well? WEST  
 5 Cess pool      10 Livestock pens      15 Oil well/Gas well      How many feet? 75'

FROM	TO	PLUGGING MATERIALS	FROM	TO	PLUGGING MATERIALS
<u>58</u>	<u>25</u>	<u>CHLORINATED GRAVEL</u>			
<u>25</u>	<u>22</u>	<u>CLAY</u>			
<u>22</u>	<u>3</u>	<u>NEAT CEMENT</u>			
<u>3</u>	<u>0</u>	<u>CASING REMOVED &amp; BACKFILL SOIL</u>			

7 CONTRACTOR'S OR LANDOWNER'S CERTIFICATION: This water well was plugged under my jurisdiction and was completed on (mo/day/year) 5/23/16 and this record is true to the best of my knowledge and belief. Kansas Water Well Contractor's License No. \_\_\_\_\_ This Water Well Record was completed on (mo/day/year) 5/20/16 under the business name of \_\_\_\_\_ by (signature) Jim Danvers

INSTRUCTIONS: Use typewriter or ballpoint pen. Please press firmly and print clearly. Please fill in blanks, underline or circle the correct answers. Send top three copies to Kansas Department of Health and Environment, Bureau of Water, Geology Section, 1000 SW Jackson St., Ste. 420, Topeka, Kansas 66612-1367. Telephone: 785/296-5522. Send one to Water Well Owner and retain one for your records. Visit us at <http://www.kdheks.gov/geo/waterwells>.