


1] LOCATION OF WATER WELL: County: Montgomery Fraction SW 1/4 NW 1/4 SE 1/4 Section Number 25 Township Number T 34 S Range Number R 16 E/W

Distance and direction from nearest town or city street address of well if located within city?
North and Linden Streets, Coffeyville, KS

2] WATER WELL OWNER: Farmland Industries
 RR#, St. Address, Box #: North and Linden Board of Agriculture, Division of Water Resource
 City, State, ZIP Code: Coffeyville, KS 67337 Application Number:

3] LOCATE WELL'S LOCATION WITH AN "X" IN SECTION BOX:

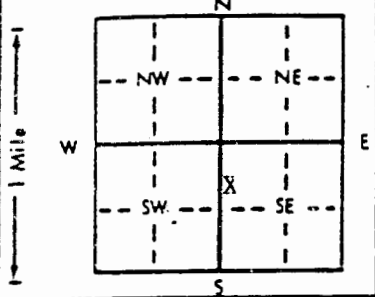

4] DEPTH OF COMPLETED WELL ... 25 ... ft. ELEVATION: ...

Depth(s) Groundwater Encountered 1. ... ft. 2. ... ft. 3. ... ft.
 WELL'S STATIC WATER LEVEL ... 16.64 ... ft. below land surface measured on mo/day/yr 11/30/94
 Pump test data: Well water was ... ft. after ... hours pumping ... gpm
 Est. Yield ... gpm: Well water was ... ft. after ... hours pumping ... gpm
 Bore Hole Diameter ... 8 ... in. to ... 25.5 ... ft., and ... in. to ... ft.
 WELL WATER TO BE USED AS: 5 Public water supply 8 Air conditioning 11 Injection well
 1 Domestic 3 Feedlot 6 Oil field water supply 9 Dewatering 12 Other (Specify below)
 2 Irrigation 4 Industrial 7 Lawn and garden only 10 Monitoring well
 Was a chemical/bacteriological sample submitted to Department? Yes ... No X; If yes, mo/day/yr sample was submitted
 Water Well Disinfected? Yes No X

5] TYPE OF BLANK CASING USED: 1 Steel 3 RMP (SR) 5 Wrought iron 8 Concrete tile CASING JOINTS: Glued ... Clamped ...
2 PVC 4 ABS 6 Asbestos-Cement 9 Other (specify below) Welded ...
 Blank casing diameter ... 2 ... in. to ... 20 ... ft., Dia ... in. to ... ft., Dia ... in. to ... ft.
 Casing height above land surface ... 30 ... in., weight ... lbs./ft. Wall thickness or gauge No. ... Sch. 40 ...

TYPE OF SCREEN OR PERFORATION MATERIAL: 1 Steel 3 Stainless steel 5 Fiberglass 7 PVC 10 Asbestos-cement
 2 Brass 4 Galvanized steel 6 Concrete tile 8 RMP (SR) 11 Other (specify) ...
 9 ABS 12 None used (open hole)

SCREEN OR PERFORATION OPENINGS ARE: 1 Continuous slot 3 Mill slot 5 Gauzed wrapped 8 Saw cut 11 None (open hole)
 2 Louvered shutter 4 Key punched 6 Wire wrapped 9 Drilled holes
 7 Torch cut 10 Other (specify) ...

SCREEN-PERFORATED INTERVALS: From ... 20 ... ft. to ... 25 ... ft., From ... ft. to ... ft.
 From ... ft. to ... ft., From ... ft. to ... ft.

GRAVEL PACK INTERVALS: From ... 18 ... ft. to ... 25.5 ... ft., From ... ft. to ... ft.
 From ... ft. to ... ft., From ... ft. to ... ft.

6] GROUT MATERIAL: 1 Neat cement 2 Cement grout 3 Bentonite 4 Other ...
 Grout Intervals: From ... 0 ... ft. to ... 16 ... ft., From ... 16 ... ft. to ... 18 ... ft., From ... ft. to ... ft.

What is the nearest source of possible contamination: 1 Septic tank 4 Lateral lines 7 Pit privy 10 Livestock pens 14 Abandoned water well
 2 Sewer lines 5 Cess pool 8 Sewage lagoon 11 Fuel storage 15 Oil well/Gas well
 3 Watertight sewer lines 6 Seepage pit 9 Feedyard 12 Fertilizer storage 16 Other (specify below) Refinery
 13 Insecticide storage
 Direction from well? Unknown How many feet? Unknown

FROM	TO	LITHOLOGIC LOG	FROM	TO	PLUGGING INTERVALS
0	5	Olive Silty Clay			
5	18	Dark Brown to Olive Silty Clay			
18	20	Orange and Black Silty Clay			
20	21	Tannish-Gray Silt			PZ1B
21	22	Silty, Sandy Gravel			
22	25.5	Shale			
					Above ground

7] CONTRACTOR'S OR LANDOWNER'S CERTIFICATION: This water well was (1) constructed, (2) reconstructed, or (3) plugged under my jurisdiction and was completed on (mo/day/year) ... 11/30/94 ... and this record is true to the best of my knowledge and belief. Kansas Water Well Contractor's License No. 527 This Water Well Record was completed on (mo/day/yr) ... 12/14/94 under the business name of GebCore Services, Inc. by (signature) Don Bell

INSTRUCTIONS: Use typewriter or ball point pen. PLEASE PRESS FIRMLY and PRINT clearly. Please fill in blanks, underline or circle the correct answers. Send top three copies to Kansas Department of Health and Environment, Bureau of Water, Topeka, Kansas 66620-0001. Telephone: 913-296-5545. Send one to WATER WELL OWNER and retain one for your records.