


1 LOCATION OF WATER WELL: Fraction  $\frac{1}{4}$   $\frac{1}{4}$  NW  $\frac{1}{4}$  Section Number **31** Township Number T **34** S Range Number R **17** **E/W**

Distance and direction from nearest town or city street address of well if located within city?  
**400 N. Linden, Coffeyville, KS**

2 WATER WELL OWNER: **Farmland Industries, Inc.**  
 RR#, St. Address, Box # : **P.O. Box 570** Board of Agriculture, Division of Water Resources  
 City, State, ZIP Code : **Coffeyville, Kansas 67337-0570** Application Number:

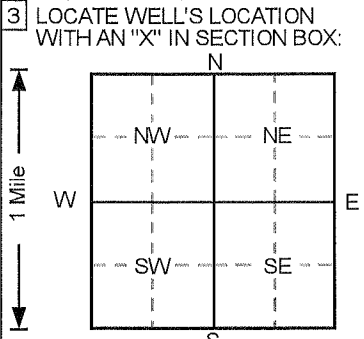

3 LOCATE WELL'S LOCATION WITH AN "X" IN SECTION BOX:

4 DEPTH OF COMPLETED WELL: **21** ft. ELEVATION: **713.63**  
 Depth(s) Groundwater Encountered: 1. **10.1** ft. 2. ... ft. 3. ... ft.  
 WELL'S STATIC WATER LEVEL: ... ft. below land surface measured on mo/day/yr  
 Pump test data: Well water was **NA** ft. after ... hours pumping ... gpm  
 Est. Yield: **NA** gpm: Well water was ... ft. after ... hours pumping ... gpm  
 Bore Hole Diameter: **8** in. to **21** ft., and ... in. to ... ft.  
 WELL WATER TO BE USED AS: 5 Public water supply 8 Air conditioning 11 Injection well  
 1 Domestic 3 Feedlot 6 Oil field water supply 9 Dewatering 12 Other (Specify below)  
 2 Irrigation 4 Industrial 7 Lawn and garden only **10** Monitoring well  
 Was a chemical/bacteriological sample submitted to Department? Yes... No ; If yes, mo/day/yr sample was submitted  
 Water Well Disinfected? Yes No

5 TYPE OF BLANK CASING USED:  
 1 Steel 3 RMP (SR) 5 Wrought iron 8 Concrete tile CASING JOINTS: Glued ... Clamped ...  
**2** PVC 4 ABS 6 Asbestos-Cement 9 Other (specify below) Welded ...  
 Blank casing diameter: **2** in. to **6** ft., Dia. ... in. to ... ft., Dia. ... in. to ... ft.  
 Casing height above land surface: **29.04** in., weight ... lbs./ft. Wall thickness or gauge No. **Sch. 40**  
 TYPE OF SCREEN OR PERFORATION MATERIAL:  
 1 Steel 3 Stainless steel 5 Fiberglass **7** PVC 10 Asbestos-cement  
 2 Brass 4 Galvanized steel 6 Concrete tile 9 ABS 11 Other (specify) ...  
 12 None used (open hole)  
 SCREEN OR PERFORATION OPENINGS ARE:  
**1** Continuous slot 3 Mill slot 5 Gauzed wrapped 8 Saw cut 11 None (open hole)  
 2 Louvered shutter 4 Key punched 6 Wire wrapped 9 Drilled holes  
 7 Torch cut 10 Other (specify) ...  
 SCREEN-PERFORATED INTERVALS: From **6** ft. to **21** ft., From ... ft. to ... ft.  
 GRAVEL PACK INTERVALS: From **4** ft. to **21** ft., From ... ft. to ... ft.

6 GROUT MATERIAL: 1 Neat cement **2** Cement grout **3** Bentonite 4 Other ...  
 Grout Intervals: From **0** ft. to **2** ft., From **2** ft. to **4** ft., From ... ft. to ... ft.  
 What is the nearest source of possible contamination:  
 1 Septic tank 4 Lateral lines 7 Pit privy 10 Livestock pens 14 Abandoned water well  
 2 Sewer lines 5 Cess pool 8 Sewage lagoon 11 Fuel storage 15 Oil well/Gas well  
 3 Watertight sewer lines 6 Seepage pit 9 Feedyard 12 Fertilizer storage **16** Other (specify below)  
**Refinery Facility**  
 Direction from well? **At Refinery** How many feet?

FROM	TO	LITHOLOGIC LOG	FROM	TO	PLUGGING INTERVALS
0	5.5	Clay, Yellow Red			
5.5	6.5	Clay, Yellow Red			
6.5	10	Clay, Yellow Red			
10	12	Sand, Light Olive Gray			
12	20	Gravel, Yellow Brown			
20	20.2	Bedrock,			
20.2	21	Limestone, Gray			

7 CONTRACTOR'S OR LANDOWNER'S CERTIFICATION: This water well was **(1)** constructed, (2) reconstructed, or (3) plugged under my jurisdiction and was completed on (mo/day/year) **12/22/95** and this record is true to the best of my knowledge and belief.  
 Kansas Water Well Contractor's License No. **527** This Water Well Record was completed on (mo/day/yr) **12/27/95**  
 under the business name of **GeoCore Services, Inc.** by (signature) *Robert Rohl*

OFFICE USE ONLY

T

R

EW

SEC.

$\frac{1}{4}$

$\frac{1}{4}$

$\frac{1}{4}$