


1 LOCATION OF WATER WELL:	Fraction	Section Number	Township Number	Range Number
County: Montgomery	NE ¼ SW ¼ NW ¼	31	T 34 S	R 17 (E/W)

Distance and direction from nearest town or city street address of well if located within city?
400 N. Linden, Coffeyville, KS

2 WATER WELL OWNER: **Farmland Industries, Inc.**
 RR#, St. Address, Box # : **P.O. Box 570**
 City, State, ZIP Code : **Coffeyville, Kansas 67337-0570**
 Board of Agriculture, Division of Water Resources
 Application Number:

3 LOCATE WELL'S LOCATION WITH AN "X" IN SECTION BOX:	<p>4 DEPTH OF COMPLETED WELL 15 ft. ELEVATION: 720.08</p> <p>Depth(s) Groundwater Encountered 1. ft. 2. ft. 3. ft.</p> <p>WELL'S STATIC WATER LEVEL ft. below land surface measured on mo/day/yr</p> <p>Pump test data: Well water was NA ft. after hours pumping gpm</p> <p>Est. Yield NA gpm; Well water was ft. after hours pumping gpm</p> <p>Bore Hole Diameter 8 in. to 17 ft., and in. to ft.</p> <p>WELL WATER TO BE USED AS: 5 Public water supply 8 Air conditioning 11 Injection well 1 Domestic 3 Feedlot 6 Oil field water supply 9 Dewatering 12 Other (Specify below) 2 Irrigation 4 Industrial 7 Lawn and garden only 10 Monitoring well</p> <p>Was a chemical/bacteriological sample submitted to Department? Yes.....No <input checked="" type="checkbox"/>; If yes, mo/day/yr sample was submitted Water Well Disinfected? Yes No <input checked="" type="checkbox"/></p>
---	--

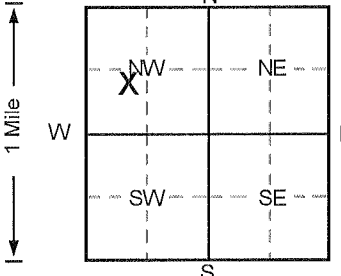

5 TYPE OF BLANK CASING USED:	1 Steel	3 RMP (SR)	5 Wrought iron	8 Concrete tile	CASING JOINTS: Glued Clamped
2 PVC	4 ABS	6 Asbestos-Cement	9 Other (specify below)	Welded	Threaded <input checked="" type="checkbox"/>
Blank casing diameter 2 in. to 5 ft., Dia in. to ft., Dia in. to ft.	Casing height above land surface 38.4 in., weight lbs./ft. Wall thickness or gauge No. Sch. 40				
TYPE OF SCREEN OR PERFORATION MATERIAL					
1 Steel	3 Stainless steel	5 Fiberglass	7 PVC	10 Asbestos-cement	11 Other (specify)
2 Brass	4 Galvanized steel	6 Concrete tile	9 ABS	12 None used (open hole)	
SCREEN OR PERFORATION OPENINGS ARE:					
1 Continuous slot	3 Mill slot	5 Gauzed wrapped	8 Saw cut	11 None (open hole)	
2 Louvered shutter	4 Key punched	6 Wire wrapped	9 Drilled holes		
SCREEN-PERFORATED INTERVALS: From 5 ft. to 15 ft., From ft. to ft. From ft. to ft., From ft. to ft.					
GRAVEL PACK INTERVALS: From 4 ft. to 17 ft., From ft. to ft. From ft. to ft., From ft. to ft.					

6 GROUT MATERIAL: 1 Neat cement **2** Cement grout **3** Bentonite 4 Other

Grout Intervals: From **0** ft. to **1** ft., From **1** ft. to **4** ft., From ft. to ft.

What is the nearest source of possible contamination:
 1 Septic tank 4 Lateral lines 7 Pit privy 10 Livestock pens 14 Abandoned water well
 2 Sewer lines 5 Cess pool 8 Sewage lagoon 11 Fuel storage 15 Oil well/Gas well
 3 Watertight sewer lines 6 Seepage pit 9 Feedyard 12 Fertilizer storage **16** Other (specify below)
 .. **Refinery Facility**

Direction from well? **At Refinery** How many feet?

FROM	TO	LITHOLOGIC LOG	FROM	TO	PLUGGING INTERVALS
0	2	Rock,			
2	9.5	Clay, Dark Olive Gray			
9.5	15.5	Clay, Yellow Brown			
15.5	17	Sand, Olive			
					RMW153 , Tag # , Abovegrade
					Project Name: Farmland Refinery-56 Wells
					GeoCore # 255 , #

7 CONTRACTOR'S OR LANDOWNER'S CERTIFICATION: This water well was **(1)** constructed, **(2)** reconstructed, or **(3)** plugged under my jurisdiction and was completed on (mo/day/year) **4/30/96** and this record is true to the best of my knowledge and belief.
 Kansas Water Well Contractor's License No. **527** This Water Well Record was completed on (mo/day/yr) **5/30/96**
 under the business name of **GeoCore Services, Inc.** by (signature) *Dub Kelly*

INSTRUCTIONS: Use typewriter or ball point pen. PLEASE PRESS FIRMLY and PRINT clearly. Please fill in blanks, underline or circle the correct answers. Send top three copies to Kansas Department of Health and Environment, Bureau of Water, Topeka, Kansas 66620-0001. Telephone: 913-296-5545. Send one to WATER WELL OWNER and retain one for your records.

OFFICE USE ONLY

T
R
EW
SEC.