


1	LOCATION OF WATER WELL: County: <u>Montgomery</u>	Fraction <u>NE 1/4 NE 1/4 SE 1/4</u>	Section Number <u>31</u>	Township Number <u>34</u>	Range Number <u>17</u>
---	--	---	-----------------------------	------------------------------	---------------------------

Distance and direction from nearest town or city street address of well if located within city?
 From east Coffeyville city limits on 169 Hwy - 1 mile east, 1/4 mile south

2 WATER WELL OWNER: Leah Rurode

RR#, St. Address, Box #: 1314 North 1 Road Board of Agriculture, Division of Water Resources
 City, State, ZIP Code : Baldwin, KS 66006 Application Number:

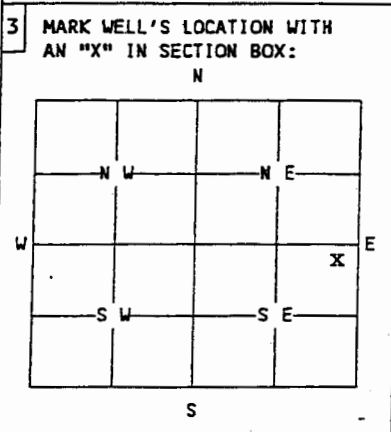

4 DEPTH OF WELL.....21.....ft. below original ground
 WELL'S STATIC WATER LEVEL.....19.....ft. below original ground

WELL WAS USED AS:

<u>1 Domestic</u>	5 Public Water Supply	9 Dewatering
2 Irrigation	6 Oil Field Water Supply	10 Monitoring Well
3 Feedlot	7 Lawn and Garden Only	11 Injection Well
4 Industrial	8 Air Conditioning	12 Other.....

Was a chemical/bacteriological sample submitted to Department? Yes.....No...X
 If yes, mo/day/yr sample was submitted.....

Water Well Disinfected: Yes.....X No.....
 Liquid chlorine 10% solution

5 TYPE OF BLANK CASING USED:

1 Steel	3 RMP (SR)	5 Wrought	7 Fiberglass	9 Other (specify below)
2 PVC	4 ABS	6 Asbestos-Cement	8 Concrete Tile	<u>Hand dug - rock wall</u>

Blank casing diameter.....in. Was casing pulled? Yes..... No..... If yes, how much.....
 Casing height above or below land surface.....in.

6 GROUT PLUG MATERIAL: 1 Neat cement. 2 Cement grout 3 Bentonite 4 Other.....

Grout Plug Intervals: From.....6.....ft. to.....3.....ft., From.....ft. to.....ft., From..... to.....ft.

What is the nearest source of possible contamination:

1 Septic tank	6 Seepage pit	11 Fuel storage	16 Other (specify below)
2 Sewer lines	7 Pit privy	12 Fertilizer storage	
3 Watertight sewer lines	8 Sewage lagoon	13 Insecticide storage	
4 Lateral lines	9 Feedyard	14 Abandoned water well	
5 Cess Pool	10 Livestock pens	15 Oil well/Gas well	

Direction from well? How many feet?

FROM	TO	PLUGGING MATERIALS
21	19	sand and gravel
19	6	clay
6	3	cement grout
3	0	clay capped w/topsoil

See note on back

7 CONTRACTOR'S OR LANDOWNER'S CERTIFICATION: This water well was plugged under my jurisdiction and was completed on (mo/day/year)..... and this record is true to the best of my knowledge and belief. Kansas Water Well Contractor's License No. 3-30-07 This Water Well Record was completed on (mo/day/year)..... under the business name of Muller Construction, Inc.
 by (signature) Mark Muller

INSTRUCTIONS: Use typewriter or ball point pen. Please press firmly and print clearly. Please fill in blanks, underline or circle the correct answers. Send top three copies to Kansas Department of Health and Environment, Bureau of Water, Topeka, Kansas 66620-0001. Telephone: 785/296-3565. Send one to Water Well Owner and retain one for your records.



This hand dug well had not been used in years. The wooden wellhouse, pump, and piping were still in place. We removed the wellhouse, plumbing, and proceeded to plug the well per the procedure listed on the front of this page.

PLUGGING of a DUG WELL


North Well

BEFORE

AFTER

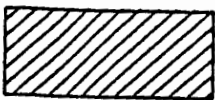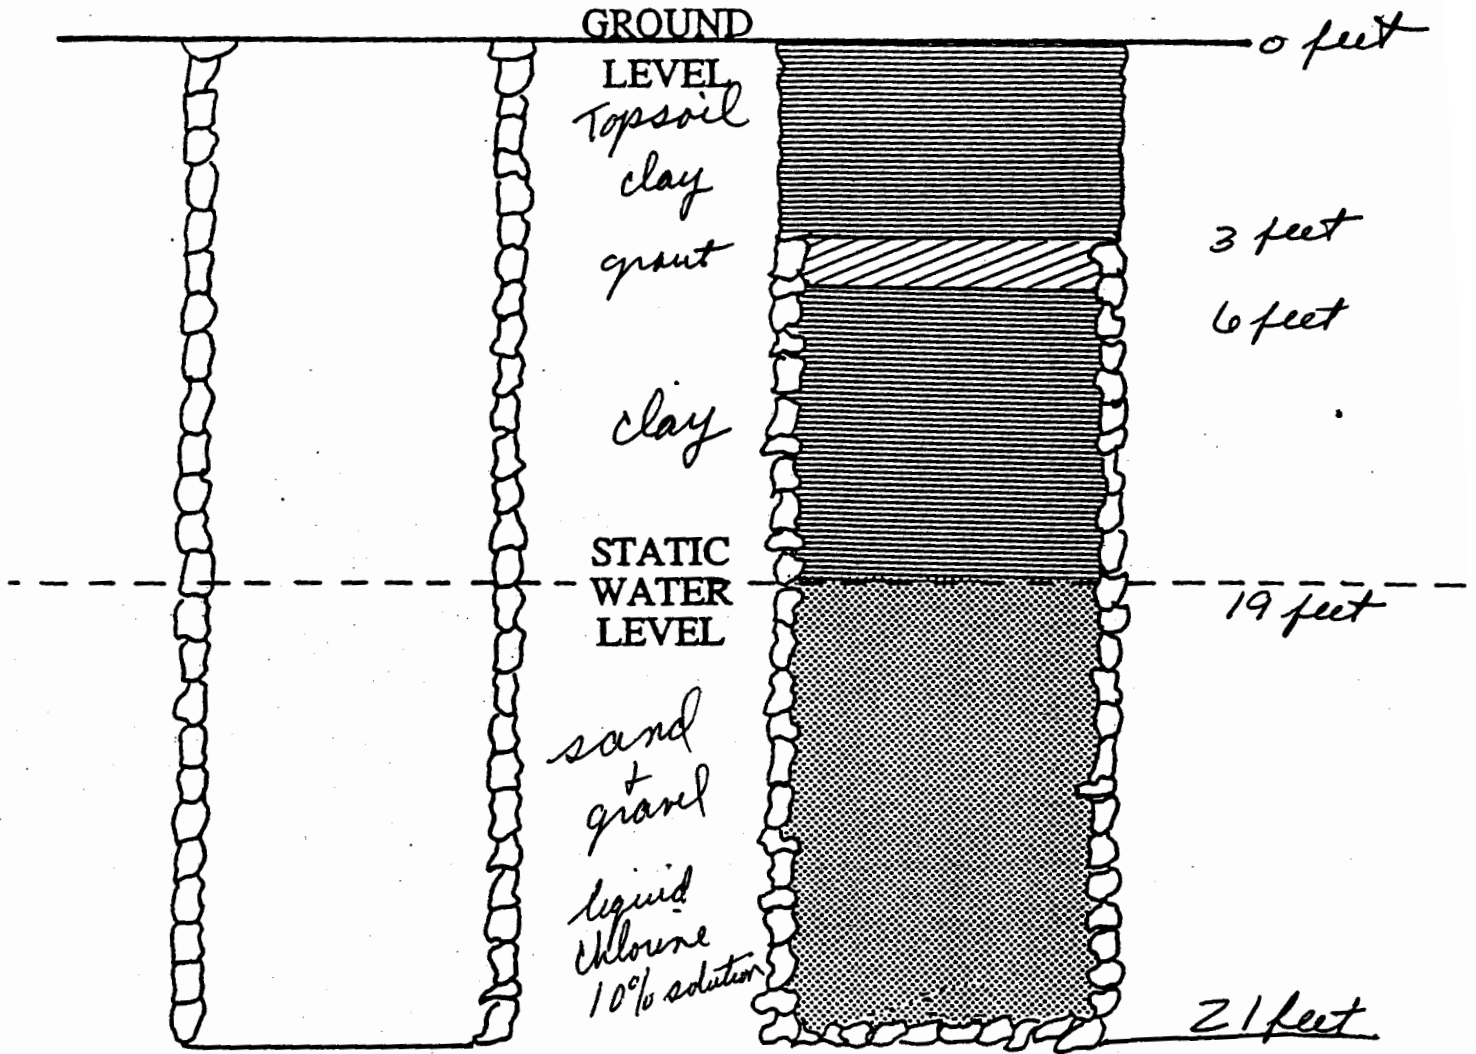


GROUT

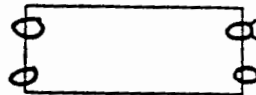


CASING RIPPED



SOIL OR CLAY

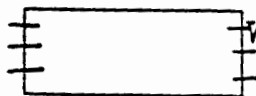

WELL SCREEN

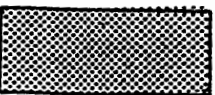

SAND & GRAVEL