

1 LOCATION OF WATER WELL:	Fraction	Section Number	Township Number	Range Number
County: Montgomery	SE 1/4 NE 1/4 SE 1/4	31	34	17

Distance and direction from nearest town or city street address of well if located within city?
 From east of Coffeyville city limits on 169 Hwy, 1 mile east, 1/4 mile south

2 WATER WELL OWNER: Leah Rurode

RR#, St. Address, Box #: 1314 North 1 Road
 City, State, ZIP Code : Baldwin, Ks 66006


Board of Agriculture, Division of Water Resources
 Application Number:

3 MARK WELL'S LOCATION WITH AN "X" IN SECTION BOX:

N

4 DEPTH OF WELL.....17.....ft. below original ground

WELL'S STATIC WATER LEVEL.....15.....ft. below original ground

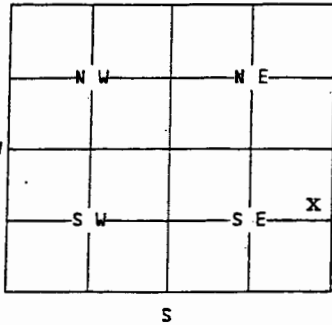

WELL WAS USED AS:

- | | | |
|--|---|---|
| <input checked="" type="checkbox"/> 1 Domestic | 5 Public Water Supply | 9 Dewatering |
| <input type="checkbox"/> 2 Irrigation | <input type="checkbox"/> 6 Oil Field Water Supply | <input type="checkbox"/> 10 Monitoring Well |
| <input type="checkbox"/> 3 Feedlot | <input type="checkbox"/> 7 Lawn and Garden Only | <input type="checkbox"/> 11 Injection Well |
| <input type="checkbox"/> 4 Industrial | <input type="checkbox"/> 8 Air Conditioning | <input type="checkbox"/> 12 Other..... |

Was a chemical/bacteriological sample submitted to Department? Yes.....No X
 If yes, mo/day/yr sample was submitted.....

Water Well Disinfected: Yes X No.....
 Liquid chlornie 10% solution

5 TYPE OF BLANK CASING USED:

1 Steel	3 RMP (SR)	5 Wrought	7 Fiberglass	9 Other (specify below)
2 PVC	4 ABS	6 Asbestos-Cement	8 Concrete Tile	Hand dug - rock wall

Blank casing diameter..... in. Was casing pulled? Yes..... No..... If yes, how much.....
 Casing height above or below land surface..... in.

6 GROUT PLUG MATERIAL: 1 Neat cement. 2 Cement grout 3 Bentonite 4 Other.....

Grout Plug Intervals: From 6 ft. to 3 ft., From.....ft. to.....ft., From..... to.....ft.

What is the nearest source of possible contamination:

- | | | |
|--------------------------|-------------------|--------------------------|
| 1 Septic tank | 6 Seepage pit | 11 Fuel storage |
| 2 Sewer lines | 7 Pit privy | 12 Fertilizer storage |
| 3 Watertight sewer lines | 8 Sewage lagoon | 13 Insecticide storage |
| 4 Lateral lines | 9 Feedyard | 14 Abandoned water well |
| 5 Cess Pool | 10 Livestock pens | 15 Oil well/Gas well |
| | | 16 Other (specify below) |

Direction from well? How many feet?

FROM	TO	PLUGGING MATERIALS
17	15	sand and gravel
15	6	clay
6	3	cement grout
3	0	clay capped with topsoil

See Note on back

7 CONTRACTOR'S OR LANDOWNER'S CERTIFICATION: This water well was plugged under my jurisdiction and was completed on (mo/day/year)..... and this record is true to the best of my knowledge and belief. Kansas Water Well Contractor's License No. This Water Well Record was completed on (mo/day/year) 03-30-07 under the business name of Muller Construction, Inc. by (signature) *M. Muller*

INSTRUCTIONS: Use typewriter or ball point pen. Please press firmly and print clearly. Please fill in blanks, underline or circle the correct answers. Send top three copies to Kansas Department of Health and Environment, Bureau of Water, Topeka, Kansas 66620-0001. Telephone: 785/296-3565. Send one to Water Well Owner and retain one for your records.



This hand dug well had not been used in years. The concrete top and walls of the well were partially collapsed. Using a trackhoe, we dug out the well and followed the plugging procedure as listed on the front of this page. The pump and piping were already gone prior to us starting on the well plugging.

PLUGGING of a DUG WELL

South Well

BEFORE


AFTER

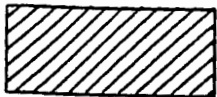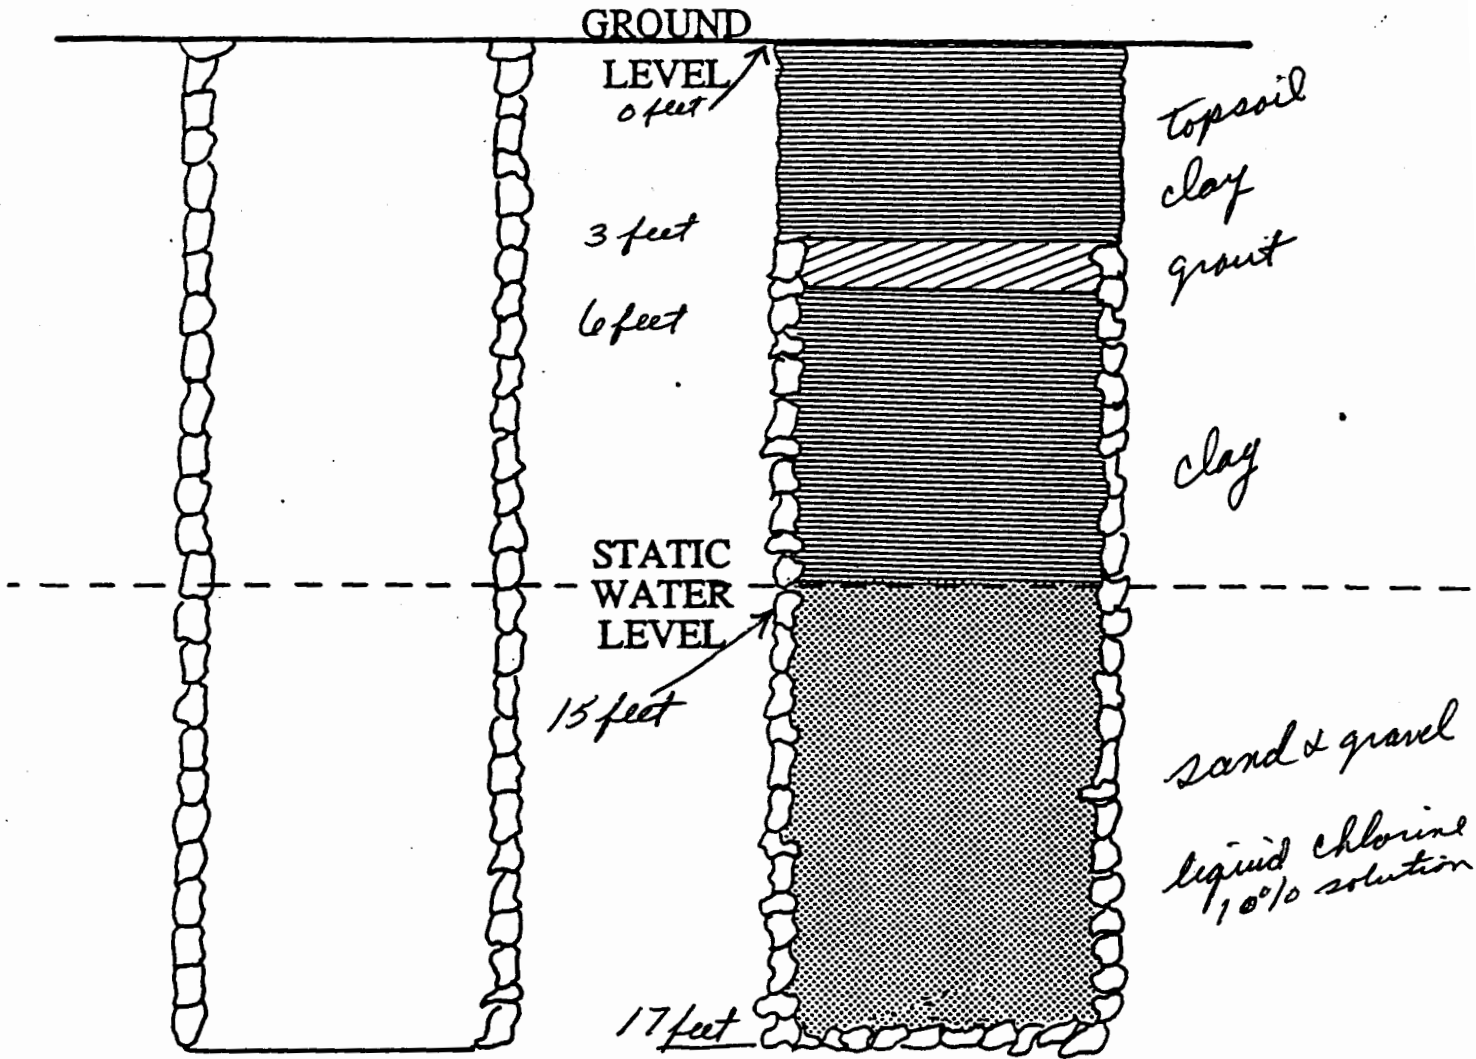


GROUT




SOIL OR CLAY

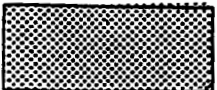

SAND & GRAVEL

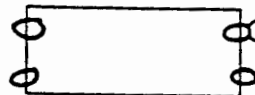

CASING RIPPED

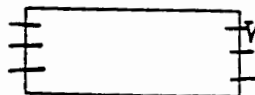

WELL SCREEN