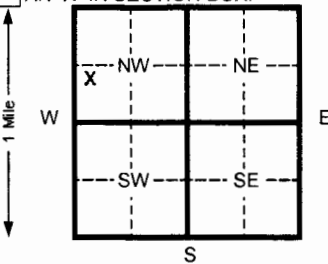


1 LOCATION OF WATER WELL: County: Montgomery	Fraction NW ¼ SW ¼ NW ¼	Section Number 31	Township Number T 34 S	Range Number R 17 E
--	-----------------------------------	-----------------------------	----------------------------------	--------------------------------------

Distance and direction from nearest town or city street address of well if located within city?

400 N. Linden, Coffeyville Refinery - Coffeyville

2 WATER WELL OWNER: Coffeyville Resources Refining and Marketing, LLC RR#, St. Address, Box # : 400 N. Linden City, State, ZIP Code : Coffeyville, KS 67337	Board of Agriculture, Division of Water Resources Application Number:
--	--

3 LOCATE WELL'S LOCATION WITH AN "X" IN SECTION BOX: 	4 DEPTH OF COMPLETED WELL 28 ft. ELEVATION: Depth(s) Groundwater Encountered 1 _____ ft. 2 _____ ft. 3 _____ ft. WELL'S STATIC WATER LEVEL _____ ft. below land surface measured on mo/day/yr Pump test data: Well water was _____ ft. after _____ hours pumping _____ gpm Est. Yield _____ gpm: Well water was _____ ft. after _____ hours pumping _____ gpm Bore Hole Diameter 12 in. to 23 ft. and 8 in. to 28 ft. WELL WATER TO BE USED AS: 5 Public water supply 8 Air conditioning 11 Injection well 1 Domestic 3 Feed lot 6 Oil field water supply 9 Dewatering 12 Other (Specify below) 2 Irrigation 4 Industrial 7 Lawn and garden (domestic) 10 Monitoring well Was a chemical/bacteriological sample submitted to Department? Yes _____ No X If yes, mo/day/yr sample was submitted Water Well Disinfected? Yes _____ No X
---	---

5 TYPE OF BLANK CASING USED: 1 Steel <input type="checkbox"/> 3 RMP (SR) 2 PVC <input type="checkbox"/> 4 ABS	5 Wrought Iron 8 Concrete tile 6 Asbestos-Cement 9 Other (specify below)	CASING JOINTS: Glued _____ Clamped _____ Welded _____ Threaded Flush
---	---	---

Blank casing diameter **6** in. to **23 (Steel)** ft., Dia **2** in. to **23 (PVC)** ft., Dia _____ in. to _____ ft.
Casing height above land surface **30 (PVC)** in., weight **0.703** lbs./ft. Wall thickness or gauge No. **SCH. 40**

TYPE OF SCREEN OR PERFORATION MATERIAL: 1 Steel 3 Stainless steel 5 Fiberglass 8 RMP (SR) 11 Other (specify) 2 Brass 4 Galvanized steel 6 Concrete tile 9 ABS 12 None used (open hole)	7 PVC <input type="checkbox"/> 10 Asbestos-cement
--	---

SCREEN OR PERFORATION OPENINGS ARE:
1 Continuous slot 3 Mill slot 6 Wire wrapped 9 Drilled holes
2 Louvered shutter 4 Key punched 7 Torch cut 10 Other (specify)
8 Saw cut 11 None (open hole)

SCREEN-PERFORATED INTERVALS: From **23** ft. to **28** ft. From _____ ft. to _____ ft.
GRAVEL PACK INTERVALS: From **23** ft. to **28** ft. From _____ ft. to _____ ft.

6 GROUT MATERIAL: 1 Neat cement <input type="checkbox"/> 2 Cement grout	3 Bentonite <input type="checkbox"/> 4 Other _____
---	--

Grout intervals From **1** ft. to **23 (outer)** ft. From **1** ft. to **23 (inner)** ft. From _____ ft. to _____ ft.
What is the nearest source of possible contamination:
1 Septic tank 4 Lateral lines 7 Pit privy 10 Livestock pens 14 Abandoned water well
2 Sewer lines 5 Cess pool 8 Sewage lagoon 11 Fuel storage 15 Oil well/ Gas well
3 Watertight sewer lines 6 Seepage pit 9 Feedyard 12 Fertilizer storage 16 Other (specify below)
13 Insecticide storage

FROM	TO	CODE	LITHOLOGIC LOG	FROM	TO	PLUGGING INTERVALS
0	7	CH	Silty Clay, dark brown, trace gravel			
5	15	CL-CH	Silty Clay, gray, with yellow brown mottles, little sand			
15	21	SC-SM	Silty Sand with Clay, gray to light gray, with yellow brown mottles, fine grained sand			
21	22	GC	Limestone - Clayey Gravel, dark gray, some silt and clay			
22	27.5		Limestone, light gray			
27.5	28		Shale, green gray			

7 CONTRACTOR'S OR LANDOWNER'S CERTIFICATION: This water well was (1) constructed , (2) reconstructed, or (3) plugged under my jurisdiction and was completed on (mo/day/yr) 03/28/08 and this record is true to the best of my knowledge and belief. Kansas Water Well Contractor's License No. 531 This Water Well Record was completed on (mo/day/yr) 05/09/08 under the business name of Geotechnical Services Inc. by signature <i>[Signature]</i>

INSTRUCTIONS: Please fill in blanks and circle the correct answers. Send three copies to Kansas Department of Health and Environment, Bureau of Water, 1000 S W Jackson St., Ste. 420, Topeka, Kansas 66612-1367. Telephone: 913-296-5545. Send one to WATER WELL OWNER and retain one for your records.