

1 LOCATION OF WATER WELL:	Fraction	Section Number	Township Number	Range Number
County: Montgomery	NW ¼ SW ¼ NW ¼	31	T 34 S	R 17 E

Distance and direction from nearest town or city street address of well if located within city?

400 N. Linden, Coffeyville Refinery - Coffeyville

2 WATER WELL OWNER: **Coffeyville Resources Refining and Marketing, LLC**


RR#, St. Address, Box # : **400 N. Linden**

Board of Agriculture, Division of Water Resources

City, State, ZIP Code : **Coffeyville, KS 67337**

Application Number:

3 LOCATE WELL'S LOCATION WITH AN "X" IN SECTION BOX:

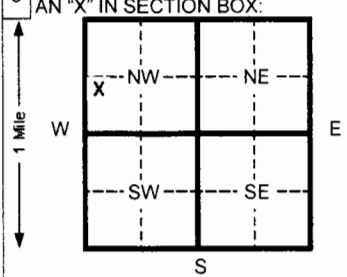

4 DEPTH OF COMPLETED WELL **24** ft. ELEVATION: **722.45 (TOC)**

Depth(s) Groundwater Encountered 1 **7** ft. 2 _____ ft. 3 _____ ft.

WELL'S STATIC WATER LEVEL _____ ft. below land surface measured on mo/day/yr

Pump test data: Well water was _____ ft. after _____ hours pumping _____ gpm

Est. Yield _____ gpm: Well water was _____ ft. after _____ hours pumping _____ gpm

Bore Hole Diameter **12** in. to **16.5** ft. and **6** in. to **24** ft.

WELL WATER TO BE USED AS: 5 Public water supply 8 Air conditioning 11 Injection well
 1 Domestic 3 Feed lot 6 Oil field water supply 9 Dewatering 12 Other (Specify below)
 2 Irrigation 4 Industrial 7 Lawn and garden (domestic) **10 Monitoring well**

Was a chemical/bacteriological sample submitted to Department? Yes _____ No **X** If yes, mo/day/yr sample was submitted _____

Water Well Disinfected? Yes _____ No **X**

5 TYPE OF BLANK CASING USED:

1 Steel	3 RMP (SR)	5 Wrought Iron	8 Concrete tile	CASING JOINTS: Glued _____ Clamped _____
2 PVC	4 ABS	6 Asbestos-Cement	9 Other (specify below)	Welded _____
		7 Fiberglass		Threaded _____ Flush

Blank casing diameter **6** in. to **16.5 (Steel)** ft., Dia **2** in. to **19 (PVC)** ft., Dia _____ in. to _____ ft.

Casing height above land surface **30 (PVC)** in., weight **0.703** lbs./ft. Wall thickness or gauge No. **SCH. 40**

TYPE OF SCREEN OR PERFORATION MATERIAL:

1 Steel	3 Stainless steel	5 Fiberglass	8 RMP (SR)	11 Other (specify)
2 Brass	4 Galvanized steel	6 Concrete tile	9 ABS	12 None used (open hole)

SCREEN OR PERFORATION OPENINGS ARE:

1 Continuous slot	3 Mill slot	5 Gauzed wrapped	8 Saw cut	11 None (open hole)
2 Louvered shutter	4 Key punched	6 Wire wrapped	9 Drilled holes	
		7 Torch cut	10 Other (specify)	

SCREEN-PERFORATED INTERVALS: From **19** ft. to **24** ft. From _____ ft. to _____ ft.

GRAVEL PACK INTERVALS: From **17.5** ft. to **24** ft. From _____ ft. to _____ ft.

6 GROUT MATERIAL: 1 Neat cement 2 Cement grout **3 Bentonite** 4 Other _____

Grout Intervals From **0.5** ft. to **16.5 (outer)** ft. From **0.5** ft. to **17.5 (inner)** ft. From _____ ft. to _____ ft.

What is the nearest source of possible contamination:

1 Septic tank	4 Lateral lines	7 Pit privy	10 Livestock pens	14 Abandoned water well
2 Sewer lines	5 Cess pool	8 Sewage lagoon	11 Fuel storage	15 Oil well/ Gas well
3 Watertight sewer lines	6 Seepage pit	9 Feedyard	12 Fertilizer storage	16 Other (specify below)
			13 Insecticide storage	

Direction from well?			How many feet?			
FROM	TO	CODE	LITHOLOGIC LOG	FROM	TO	PLUGGING INTERVALS
0	10	CH	Silty Clay, dark brown to dark yellow-brown with gray mottle			
10	15	SC-SM	Silty Sand with Clay, yellow-brown			
15	16	GC	Clayey Gravel, yellow-brown			
16	24		Limestone, light gray, weathered top 0.5'			

7 CONTRACTOR'S OR LANDOWNER'S CERTIFICATION: This water well was **(1) constructed**, (2) reconstructed, or (3) plugged under my jurisdiction and was completed on (mo/day/yr) **04/09/09** and this record is true to the best of my knowledge and belief. Kansas Water Well Contractor's License No. **531** This Water Well Record was completed on (mo/day/yr) **05/04/09** under the business name of **Geotechnical Services Inc.** by (signature) _____

INSTRUCTIONS: Please fill in blanks and circle the correct answers. Send three copies to Kansas Department of Health and Environment, Bureau of Water, 1000 S W Jackson St., Ste. 420, Topeka, Kansas 66612-1367. Telephone: 913-296-5545. Send one to WATER WELL OWNER and retain one for your records.