


1 LOCATION OF WATER WELL:	Fraction	Section Number	Township Number	Range Number
County: Montgomery	NE ¼ SE ¼ SE ¼	18	T 34 S	R 17 E

Distance and direction from nearest town or city street address of well if located within city?
Northeast of intersection of Hwy. 169 and County Rd. 2400 - Coffeyville

2 WATER WELL OWNER: American Insulated Wire Corp. c/o Leviton Manufacturing Co., Inc.	Board of Agriculture, Division of Water Resources
RR#, St. Address, Box # : 201 N. Service Rd.	Application Number:
City, State, ZIP Code : Melville, NY 11747	

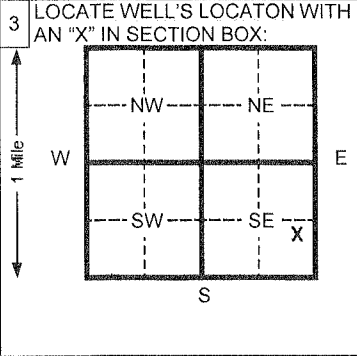

3 DEPTH OF COMPLETED WELL	30 ft.	ELEVATION:	739.11 (TOC)
Depth(s) Groundwater Encountered	1 15 ft.	2 _____ ft.	3 _____ ft.
WELL'S STATIC WATER LEVEL _____ ft. below land surface measured on mo/day/yr			
Pump test data: Well water was _____ ft. after _____ hours pumping _____ gpm			
Est. Yield _____ gpm: Well water was _____ ft. after _____ hours pumping _____ gpm			
Bore Hole Diameter	8.25 in. to 30 ft.	and _____ in. to _____ ft.	
WELL WATER TO BE USED AS:			
1 Domestic	2 Irrigation	3 Feed lot	4 Industrial
5 Public water supply	6 Oil field water supply	7 Lawn and garden (domestic)	8 Air conditioning
9 Dewatering	10 Monitoring well	11 Injection well	12 Other (Specify below)
Was a chemical/bacteriological sample submitted to Department? Yes _____ No X If yes, mo/day/yr sample was submitted			
Water Well Disinfected? Yes _____ No X			

OFFICE USE ONLY

5 TYPE OF BLANK CASING USED:	1 Steel	2 PVC	3 RMP (SR)	4 ABS	5 Wrought Iron	6 Asbestos-Cement	7 Fiberglass	8 Concrete tile	9 Other (specify below)	CASING JOINTS: Glued _____ Clamped _____	
Blank casing diameter	2 in. to 25 ft.	Dia _____ in. to _____ ft.		Dia _____ in. to _____ ft.		Dia _____ in. to _____ ft.		Wall thickness or gauge No. SCH. 40			
Casing height above land surface	29 in.	weight _____ lbs./ft.		Wall thickness or gauge No. SCH. 40		_____					
TYPE OF SCREEN OR PERFORATION MATERIAL:											
1 Steel	2 Brass	3 Stainless steel	4 Galvanized steel	5 Fiberglass	6 Concrete tile	7 PVC	8 RMP (SR)	9 ABS	10 Asbestos-cement	11 Other (specify) _____	12 None used (open hole)
SCREEN OR PERFORATION OPENINGS ARE:											
1 Continuous slot	2 Louvered shutter	3 Mill slot	4 Key punched	5 Gauzed wrapped	6 Wire wrapped	7 Torch cut	8 Saw cut	9 Drilled holes	10 Other (specify) _____	11 None (open hole)	
SCREEN-PERFORATED INTERVALS:											
From 25 ft. to 30 ft.			From _____ ft. to _____ ft.			From _____ ft. to _____ ft.			From _____ ft. to _____ ft.		
GRAVEL PACK INTERVALS:											
From 22 ft. to 30 ft.			From _____ ft. to _____ ft.			From _____ ft. to _____ ft.			From _____ ft. to _____ ft.		

T
R

6 GROUT MATERIAL:	1 Neat cement	2 Cement grout	3 Bentonite	4 Other
Grout Intervals	From 2 ft. to 22 ft.	From _____ ft. to _____ ft.	From _____ ft. to _____ ft.	From _____ ft. to _____ ft.
What is the nearest source of possible contamination:				
1 Septic tank	2 Sewer lines	3 Watertight sewer lines	4 Lateral lines	5 Cess pool
6 Seepage pit	7 Pit privy	8 Sewage lagoon	9 Feedyard	10 Livestock pens
11 Fuel storage	12 Fertilizer storage	13 Insecticide storage	14 Abandoned water well	15 Oil well/ Gas well
16 Other (specify below)				
Direction from well?		How many feet?		

FROM	TO	CODE	LITHOLOGIC LOG	FROM	TO	PLUGGING INTERVALS
0	10		Silty Clay, very dark gray to gray brown			
10	20		Sandy Clay, yellow brown			
20	30		Sand, well graded, very fine to coarse grained			

SEC

7 CONTRACTOR'S OR LANDOWNER'S CERTIFICATION: This water well was (1) constructed , (2) reconstructed, or (3) plugged under my jurisdiction and was completed on (mo/day/yr) 06/27/11 and this record is true to the best of my knowledge and belief. Kansas Water Well Contractor's License No. 531 This Water Well Record was completed on (mo/day/yr) 07/01/11 under the business name of Geotechnical Services Inc. by (signature) _____
--

INSTRUCTIONS: Please fill in blanks and circle the correct answers. Send three copies to Kansas Department of Health and Environment, Bureau of Water, 1000 S W Jackson St., Ste. 420, Topeka, Kansas 66612-1367. Telephone: 913-296-5545. Send one to WATER WELL OWNER and retain one for your records.