


1 LOCATION OF WATER WELL: County: Montgomery Fraction SW 1/4 NW 1/4 1/4 Section Number 31 Township Number 34 Range Number 17 EW

Distance and direction from nearest town or city street address of well if located within city?
1008 E. 3rd Street (LOCATED ON Southern edge of Alley easement between E. 3rd & E 4th Street in 1000 Block)

2 WATER WELL OWNER: Cotteyville Resources Global Positioning Systems (decimal degrees, min. of 4 digits)
 RR#, St. Address, Box #: 808 East New
 City, State ZIP Code: Cotteyville, KS. 67337
 Latitude: _____
 Longitude: _____
 Elevation: _____
 Datum: _____
 Data Collection Method: _____

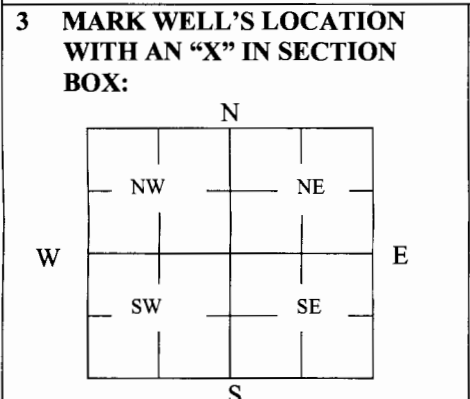

4 DEPTH OF WELL 19 ft.
 WELL'S STATIC WATER LEVEL 13'7 ft.
 WELL WAS USED AS:
 1 Domestic 2 Irrigation 3 Feedlot 4 Industrial 5 Public Water Supply 6 Oil Field Water Supply 7 Domestic (Lawn & Garden) 8 Air Conditioning 9 Dewatering 10 Monitoring 11 Injection Well 12 Other _____
 Was a chemical/bacteriological sample submitted to Department? Yes _____ No _____

5 TYPE OF BLANK CASING USED:
 1 Steel 2 PVC 3 RMP (SR) 4 ABS 5 Wrought 6 Asbestos-Cement 7 Fiberglass 8 Concrete Tile 9 Other (Specify below) _____
 Blank casing diameter 4 in. Was casing pulled? Yes _____ No X If yes, how much _____
 Casing height above or below land surface 48 in.

6 GROUT PLUG MATERIAL: 1 Neat cement 2 Cement grout 3 Bentonite 4 Other _____
 Grout Plug Intervals: From 13'7 ft. to 4 ft., From _____ ft. to _____ ft., From _____ to _____ ft.
 What is the nearest source of possible contamination:
 1 Septic tank 2 Sewer lines 3 Watertight sewer lines 4 Lateral lines 5 Cess pool 6 Seepage pit 7 Pit privy 8 Sewage lagoon 9 Feedyard 10 Livestock pens 11 Fuel Storage 12 Fertilizer storage 13 Insecticide storage 14 Abandoned water well 15 Oil well/Gas well 16 Other (specify below) _____
 Direction from well? Southeast
 How many feet? 200'

FROM	TO	PLUGGING MATERIALS	FROM	TO	PLUGGING MATERIALS
<u>19'</u>	<u>13'7</u>	<u>Chlorinated Gravel</u>			
<u>13'7</u>	<u>4'</u>	<u>Cement Grout</u>			
<u>4'</u>	<u>0'</u>	<u>CLAY SOIL</u>			

7 CONTRACTOR'S OR LANDOWNER'S CERTIFICATION: This water well was plugged under my jurisdiction and was completed on (mo/day/year) 9-12-2011 and this record is true to the best of my knowledge and belief. Kansas Water Well Contractor's License No. _____ This Water Well Record was completed on (mo/day/year) _____ under the business name of McClurg Plumbing by (signature) Bill McClurg

INSTRUCTIONS: Use typewriter or ballpoint pen. Please press firmly and print clearly. Please fill in blanks, underline or circle the correct answers. Send top three copies to Kansas Department of Health and Environment, Bureau of Water, Geology Section, 1000 SW Jackson St., Ste. 420, Topeka, Kansas 66612-1367. Telephone: 785/296-5522. Send one to Water Well Owner and retain one for your records. Visit us at <http://www.kdheks.gov/geo/waterwells>.