


1 LOCATION OF WATER WELL: Fraction NE 1/4 SW 1/4 SW 1/4 Section Number 31 Township Number T 34 S Range Number R 17 E/W  
 County: Montgomery  
 Distance and direction from nearest town or city street address of well if located within city?  
1110 S. 6th St., Cottleville

2 WATER WELL OWNER: Fuel Mktg Co. Board of Agriculture, Division of Water Resources  
 RR#, St. Address, Box #: One Coastal Application Number:  
 City, State, ZIP Code: Willow Springs, Mo

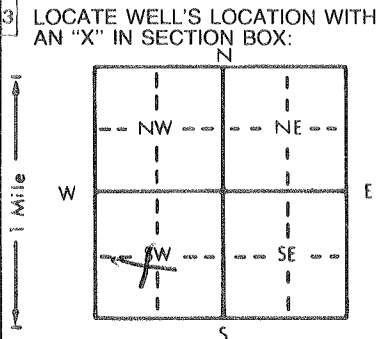

4 DEPTH OF COMPLETED WELL: 15 ft. ELEVATION:  
 WELL'S STATIC WATER LEVEL 8.98 ft. below land surface measured on mo/day/yr 9/2/97  
 WELL WATER TO BE USED AS: 5 Public water supply 8 Air conditioning 11 Injection well  
 1 Domestic 3 Feedlot 6 Oil field water supply 9 Dewatering 12 Other (Specify below)  
 2 Irrigation 4 Industrial 7 Lawn and garden only 10 Monitoring well  
 Was a chemical/bacteriological sample submitted to Department? Yes No; If yes, mo/day/yr sample was submitted  
 Water Well Disinfected? Yes No

5 TYPE OF CASING USED: 1 Steel 3 RMP (SR) 6 Asbestos-Cement 9 Other (specify below) CASING JOINTS: Glued Clamped  
2 PVC 4 ABS 7 Fiberglass Threaded  
 Blank casing diameter 2 in. to 4.5 ft., Dia 2 in. to 4.5 ft., Dia 2 in. to 4.5 ft.  
 Casing height above land surface 0 in., weight 0 lbs./ft. Wall thickness or gauge No. 0  
 TYPE OF SCREEN OR PERFORATION MATERIAL: 7 PVC 10 Asbestos-cement  
 1 Steel 3 Stainless steel 5 Fiberglass 8 RMP (SR) 11 Other (specify) 0  
 2 Brass 4 Galvanized steel 6 Concrete tile 9 ABS 12 None used (open hole)  
 SCREEN OR PERFORATION OPENINGS ARE: 5 Gauzed wrapped 8 Saw cut 11 None (open hole)  
 1 Continuous slot 3 Mill slot 6 Wire wrapped 9 Drilled holes  
 2 Louvered shutter 4 Key punched 7 Torch cut 10 Other (specify) 0  
 SCREEN-PERFORATED INTERVALS: From 4.5 ft. to 14.5 ft., From 0 ft. to 0 ft.  
 From 0 ft. to 0 ft., From 0 ft. to 0 ft.  
 GRAVEL PACK INTERVALS: From 3.41 ft. to 15 ft., From 0 ft. to 0 ft.  
 From 0 ft. to 0 ft., From 0 ft. to 0 ft.

6 GROUT MATERIAL: 1 Neat cement 2 Cement grout 3 Bentonite 4 Other 0  
 Grout Intervals: From 0 ft. to 1 ft., From 1 ft. to 3.41 ft., From 0 ft. to 0 ft.  
 What is the nearest source of possible contamination: 10 Livestock pens 14 Abandoned water well  
 1 Septic tank 4 Lateral lines 7 Pit privy 11 Fuel storage 15 Oil well/Gas well  
 2 Sewer lines 5 Cess pool 8 Sewage lagoon 12 Fertilizer storage 16 Other (specify below)  
 3 Watertight sewer lines 6 Seepage pit 9 Feedyard 13 Insecticide storage UST Basins  
 Direction from well? 0 How many feet?

FROM	TO	LITHOLOGIC LOG	FROM	TO	PLUGGING INTERVALS
0	1	Topsoil, black, organic			
1	3	Clay, black, fine sand			
3	5	Clay, gray black, fine sand			
5	8	Clay, gray, fine sand			
8	10	Clay, gray green, fine sand			
10	12	Clay, brown, very sandy - f-c			
12	15	Sand, f-c, brown, silty			

Flushmont waiver by D. Taylor

7 CONTRACTOR'S OR LANDOWNER'S CERTIFICATION: This water well was (1) constructed, (2) reconstructed, or (3) plugged under my jurisdiction and was completed on (mo/day/year) 8/19-20/97 and this record is true to the best of my knowledge and belief. Kansas Water Well Contractor's License No. 483 This Water Well Record was completed on (mo/day/yr) 12/1/97 under the business name of T.E.S.T. by (signature) Bob Robison by CL

INSTRUCTIONS: Use typewriter or ball point pen. PLEASE PRESS FIRMLY and PRINT clearly. Please fill in blanks, underline or circle the correct answers. Send top three copies to Kansas Department of Health and Environment, Bureau of Water, Topeka, Kansas 66620-0001. Telephone: 913-296-5545. Send one to WATER WELL OWNER and retain one for your records.