

WATER WELL RECORD Form WWC-5 KSA 82a-1212


1 LOCATION OF WATER WELL: County: Montgomery Fraction: NE 1/4 SW 1/4 SW 1/4 Section Number: 31 Township Number: T 34 S Range Number: R 17 E

Distance and direction from nearest town or city street address of well if located within city?

1110 S. 6th St. Coffeyville, KS

2 WATER WELL OWNER: Grace Energy RR#: Box 514 City: Willow Springs, Mo Application Number: MW4 Board of Agriculture, Division of Water Resources

3 LOCATE WELL'S LOCATION WITH AN 'X' IN SECTION BOX:

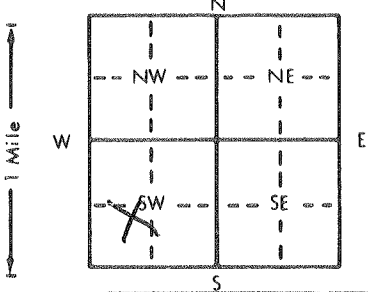

4 DEPTH OF COMPLETED WELL: 15 ft. ELEVATION: 713.94 Depth(s) Groundwater Encountered: 1-10 ft. WELL'S STATIC WATER LEVEL: 8.60 ft. below land surface measured on mo/day/yr: 9/2/97

5 TYPE OF BLANK CASING USED: 2 PVC Blank casing diameter: 2 in. to 5 ft. Dia. TYPE OF SCREEN OR PERFORATION MATERIAL: 7 PVC SCREEN OR PERFORATION OPENINGS ARE: 3 Mill slot SCREEN-PERFORATED INTERVALS: From 5 ft. to 15 ft. GRAVEL PACK INTERVALS: From 4 ft. to 15 ft.

6 GROUT MATERIAL: 2 Cement grout Grout Intervals: From 0 ft. to 2 ft., From 2 ft. to 4 ft. What is the nearest source of possible contamination: 16 Other (specify below): LUST Basins

Direction from well? LITHOLOGIC LOG FROM TO PLUGGING INTERVALS FROM TO

5	7	Clay, Lt. Brown, gray, minor silt Sand, fm, Lt. Brown, some silt		
10	12			

Flushment Waiver
By D. Taylor

7 CONTRACTOR'S OR LANDOWNER'S CERTIFICATION: This water well was (1) constructed, (2) reconstructed, or (3) plugged under my jurisdiction and was completed on (mo/day/year) 8/19-20/97 and this record is true to the best of my knowledge and belief. Kansas Water Well Contractor's License No. 423 This Water Well Record was completed on (mo/day/yr) 12/1/97 under the business name of T.E.S.T. by (signature) Bob Robinson by LL