

WATER WELL RECORD

Form WWC-5

Division of Water Resources App. No.


Well ID

MW2R

Original Record Correction Change in Well Ust

1 LOCATION OF WATER WELL: County Montgomer Fraction SW 1/4 NW 1/4 SW 1/4 Section Number 31 Township Number T 34 S Range Number R 17 E W

2 WELL OWNER: Last Name: First: Street or Rural Address where well is located (if unknown, distance and direction from nearest town or intersection):

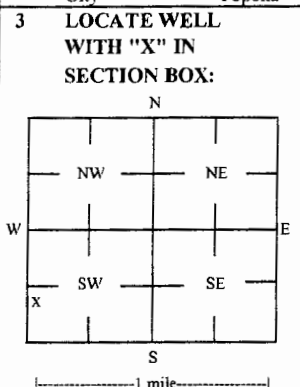

4 DEPTH OF COMPLETED WELL: 16 ft Depth(s) Groundwater Encountered: 1) 16 ft 2) ft 3) ft or 4) Dry Well WELL'S STATIC WATER LEVEL: 6.86 ft

5 Latitude: 37.03663 (decimal degrees) Longitude: 95.59908 (decimal degrees) Horizontal Datum: X WGS 84 Source for Latitude/Longitude: X Land Survey

7 WELL WATER TO BE USED AS: 1 Domestic: 5 Public Water Supply: well ID 10 Oil Field Water Supply: lease 11 Test Hole: well ID

Was a chemical/bacteriological sample submitted to KDHE? Yes No Water well disinfected? Yes No

8 TYPE OF CASING USED: Steel PVC Other CASING JOINTS: Glued Clamped Welded Threaded Casing diameter 2 in. to 6 ft

9 GROUT MATERIAL: Neat cement Cement grout Bentonite Other Concrete: 0-0.5' Grout intervals: From 0.5 ft. to 4.5 ft.

Nearest source of possible contamination: Septic Tank Lateral Lines Pit Privy Livestock Pens Insecticide Storage Sewer Lines Cess Pool Sewage Lagoon Fuel Storage Abandoned Water Well

Table with columns: 10 FROM, TO, LITHOLOGIC LOG, FROM, TO, LITHO. LOG (cont.) or PLUGGING INTERVALS. Rows show depth intervals from 0 to 16.5 ft with lithology descriptions like Topsoil, Silty clay w/ organics, Silty clay.

Notes: KDHE ID: 701 Northeast St; U3-063-14549 Target of monitoring well is shallow groundwater, <20' of grout was installed at the direction of KDHE.

11 CONTRACTOR'S OR LANDOWNER'S CERTIFICATION: This water well was constructed, reconstructed, or plugged under my jurisdiction and was completed on (mo-day-year) 1/16/17

TRITERRA LAND SERVICES

P.O. Box 546
Clearwater, Kansas 67026
Cell (316) 648-3617 Fax (620) 584-4371
E-mail: triterrals@yahoo.com

SURVEYING OF REPLACEMENT MONITORING WELLS
701 NORTHEAST STREET
COFFEYVILLE, KANSAS

The above site is in Section 31, Township 34 South, Range 17 East of the Sixth Principal Meridian, Montgomery County, Kansas. The Southeast corner of Section 31 was assigned coordinates of 00.00 North and 00.00 West.

The previously established control point was destroyed. A new one was created on site. It is described as a chiseled 'X' on the top of curb at the southwest corner of the northwest parking area.

The Latitude and Longitude were recorded from a GPS device. The site is located on the quad map titled "Coffeyville East".

ID	NORTH	WEST	LATITUDE	LONGITUDE	ELEVATION
SE CORNER 31-34S-17E	00.00	00.00			
	(Irregular Section)				
Control Point	848.71	6320.53	37.03669	95.59930	715.98
MW-1R SW NW SW SW	778.70	6278.69	37.03651	95.59910	RIM 714.90 TOC 714.55
MW-2R SW NW SW SW	820.11	6274.54	37.03663	95.59908	RIM 715.79 TOC 715.33
MW-3R SW NW SW SW	739.94	6232.98	37.03640	95.59897	RIM 714.94 TOC 714.50
MW-4R SW NW SW SW	860.38	6295.40	37.03672	95.59914	RIM 715.03 TOC 714.66
MW-8R SW NW SW SW	680.64	6261.49	37.03621	95.59904	RIM 715.03 TOC 714.67



RECEIVED
FEB 24 2017
BUREAU OF WATER