

MW6R


1 LOCATION OF WATER WELL: County: Montgomery Fraction 1/4 NE 1/4 SW 1/4 SW 1/4 Section Number 31 Township Number T 34 S Range Number 17 [X] E [] W

Street/Rural Address of Well Location: if unknown, distance & direction from nearest town or intersection: If at owner's address, check here [] 1110 E 6th St., Coffeyville, KS

Global Positioning Systems (GPS) information: Latitude: NA (in decimal degrees) Longitude: NA (in decimal degrees) Elevation: NA Horizontal Datum [] WGS84, [] NAD83, [] NAD27 Collection Method:

2 WATER WELL OWNER: Dakota Leasing/Fuel Marketing Co. RR#, St. Address, Box #: PO Box 538 / PO Box 218 City, State ZIP Code: Carthage, MO / Willow Springs, MO

GPS unit (Make/model): Digital Map/Photo, [] Topographic Map [] Land Survey Est. Accuracy: [] <3 m, [] 3-5 m, [] 5-15 m, [] >15 m

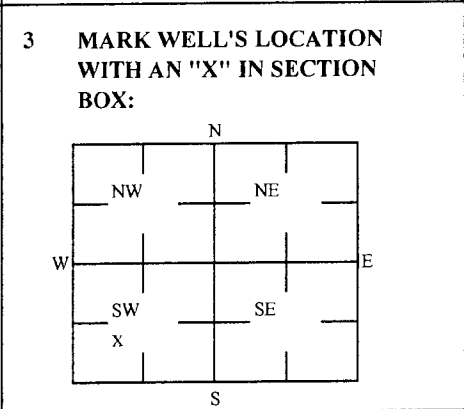

4 DEPTH OF WELL 14.96 ft. MW6R WELL'S STATIC WATER LEVEL NA ft WELL WAS USED AS: [] Domestic [] Irrigation [] Feedlot [] Industrial [] Public Water Supply [] Oil Field Water Supply [] Domestic (Lawn & Garden) [] Air Conditioning [] Dewatering [X] Monitoring [] Injection Well [] Other Was a chemical/bacteriological sample submitted to Department? Yes [] No [X]

5 TYPE OF BLANK CASING USED: [X] Steel [] PVC [] RMP (SR) [] ABS [] Wrought [] Asbestos-Cement [] Fiberglass [] Concrete Tile [] Other (Specific below) Blank casing diameter 2 in. Casing high above or below land surface NA in. Was casing pulled? Yes [X] No [] If yes, how much 3'

6 GROUT PLUG MATERIAL: [] Neat cement [] Cement grout [X] Bentonite [X] Other Soil: 0-3' Grout Plug Intervals: From 3 ft to 14.96 ft, From ft to ft, From ft to ft. What is the nearest source of possible contamination: [] Septic tank [] Sewer lines [] Watertight sewer lines [] Lateral lines [] Cess pool [] Seepage pit [] Pit privy [] Sewage lagoon [] Feed yard [] Livestock pens [] Fuel storage [] Fertilizer storage [] Insecticide storage [] Abandoned water well [] Oil well/Gas well [] Other (specify below) Direction from well? How many feet?

Table with columns: FROM, TO, PLUGGING MATERIALS. Row 1: 0, 3, Soil. Row 2: 3, 14.96, Bentonite. Includes KDHE ID: Fuel Marketing Corp. / Jones Apco; U3-063-10404/00612

7 CONTRACTOR'S OR LANDOWNER'S CERTIFICATION: This water well was plugged under my jurisdiction and was completed on (mo/day/year) 8/23/2017 and this record is true to the best of my knowledge and belief. Kansas Water Contractor's License No. 757. This Water Well Record was completed on (mo/day/year) 8/27/2017 under the business name of Larsen & Associates, Inc. By (signature) [Signature]

Send one white copy to Kansas Department of Health & Environment, Geology Section, 1000 SW Jackson Street, Ste. 420, Topeka, KS 66612-1367. Send one copy to WATER WELL OWNER and retain one for your records Visit us at http://www.kdheks.gov/waterwell/index.html Telephone 785-296-5524.