








**Coffeyville Industrial Park**  
**Coffeyville, KS**  
**KDHE#:C3-063-72398**



**FIGURE: 2.0**  
**DATE: 05.19.2021**  
**DRAWN BY:PM**

**FIGURE NAME: Site Base Map**  
**PROJECT NUMBER: 2074026**  
**PROJECT MANAGER: MB**

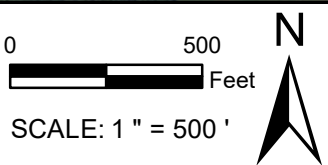

Legend	
Monitoring Well Locations	Approximate Site Boundary
Sites	Clean Harbors Facility Boundary

ALL LOCATIONS AND BOUNDARIES ARE APPROXIMATE