




Coffeyville Industrial Park
Coffeyville, KS
KDHE#:C3-063-72398

FIGURE: 2.0
DATE: 05.19.2021
DRAWN BY:PM

FIGURE NAME: Site Base Map
PROJECT NUMBER: 2074026
PROJECT MANAGER: MB

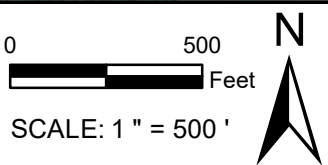

Legend	
Monitoring Well Locations	Approximate Site Boundary
Sites	Clean Harbors Facility Boundary

ALL LOCATIONS AND BOUNDARIES ARE APPROXIMATE

