


mw-8

1 LOCATION OF WATER WELL: Fraction **SW 1/4 NE 1/4 SW 1/4** Section Number **34** Township Number **T 34 S** Range Number **R 21 EW**
 County: **Labette**

Distance and direction from nearest town or city street address of well if located within city?
in alley 250' s. of 10th + Walnut; 100' w. of 10th street

2 WATER WELL OWNER: RR#, St. Address, Box # : **Carm 'n' Dales Attn: Dale Thomas** Board of Agriculture, Division of Water Resources
 City, State, ZIP Code : **P.O. Box 61, Chetopa, Kansas 67336** Application Number: -----

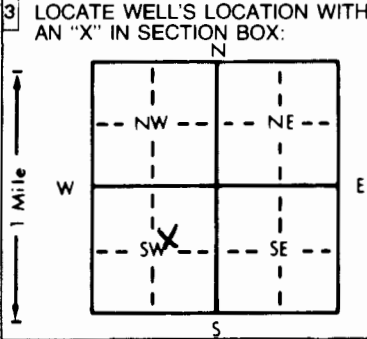

4 DEPTH OF COMPLETED WELL: **14** ft. ELEVATION: -----
 Depth(s) Groundwater Encountered 1. ----- ft. 2. ----- ft. 3. ----- ft.
 WELL'S STATIC WATER LEVEL **2.68** ft. below land surface measured on mo/day/yr **5-29-97**
 Pump test data: Well water was ----- ft. after ----- hours pumping ----- gpm
 Est. Yield ----- gpm: Well water was ----- ft. after ----- hours pumping ----- gpm
 Bore Hole Diameter: **8.625** in. to **14** in. and ----- in. to ----- ft.
 WELL WATER TO BE USED AS: 5 Public water supply 8 Air conditioning 11 Injection well
 1 Domestic 3 Feedlot 6 Oil field water supply 9 Dewatering 12 Other (Specify below)
 2 Irrigation 4 Industrial 7 Lawn and garden only **10 Monitoring well mw-8**
 Was a chemical/bacteriological sample submitted to Department? Yes ----- No **X**; If yes, mo/day/yr sample was submitted -----
 Water Well Disinfected? Yes ----- No **X**

5 TYPE OF BLANK CASING USED: 5 Wrought iron 8 Concrete tile CASING JOINTS: Glued ----- Clamped -----
 1 Steel 3 RMP (SR) 6 Asbestos-Cement 9 Other (specify below) Welded -----
 2 PVC 4 ABS 7 Fiberglass ----- Threaded **X**
 Blank casing diameter **2** in. to **4** ft., Dia. ----- in. to ----- ft., Dia. ----- in. to ----- ft.
 Casing height above land surface ----- in., weight **SCH 40 PVC** lbs./ft. Wall thickness or gauge No. -----
 TYPE OF SCREEN OR PERFORATION MATERIAL: 7 PVC 10 Asbestos-cement
 1 Steel 3 Stainless steel 5 Fiberglass 8 RMP (SR) 11 Other (specify) -----
 2 Brass 4 Galvanized steel 6 Concrete tile 9 ABS 12 None used (open hole)
 SCREEN OR PERFORATION OPENINGS ARE: 5 Gauzed wrapped 8 Saw cut 11 None (open hole)
 1 Continuous slot 3 Mill slot 6 Wire wrapped 9 Drilled holes
 2 Louvered shutter 4 Key punched 7 Torch cut 10 Other (specify) -----
 SCREEN-PERFORATED INTERVALS: From **4** ft. to **14** ft., From ----- ft. to ----- ft.
 GRAVEL PACK INTERVALS: From **3** ft. to **14** ft., From ----- ft. to ----- ft.

6 GROUT MATERIAL: 1 Neat cement 2 Cement grout 3 Bentonite 4 Other -----
 Grout Intervals: From **0** ft. to **1** ft., From **1** ft. to **4** ft., From ----- ft. to ----- ft.
 What is the nearest source of possible contamination: 10 Livestock pens 14 Abandoned water well
 1 Septic tank 4 Lateral lines 7 Pit privy 11 Fuel storage 15 Oil well/Gas well
 2 Sewer lines 5 Cess pool 8 Sewage lagoon 12 Fertilizer storage 16 Other (specify below)
 3 Watertight sewer lines 6 Seepage pit 9 Feedyard 13 Insecticide storage **UST contaminated sub**
 Direction from well? ----- How many feet? -----

| FROM | TO | LITHOLOGIC LOG | FROM | TO | PLUGGING INTERVALS |
|------|-------|---------------------------------|------|----|--------------------|
| GL | 1.00 | Driveway gravel silts and clays | | | |
| | 1.00 | Silty Clay (CL) | | | |
| | 9.00 | Clayey Silt (ML) | | | |
| | 14.00 | TD End of Borehole | | | |

D. Taylor
 Flush Mount Wai
 12/27/97

7 CONTRACTOR'S OR LANDOWNER'S CERTIFICATION: This water well was (1) constructed, (2) reconstructed, or (3) plugged under my jurisdiction and was completed on (mo/day/year) **5-7-97** and this record is true to the best of my knowledge and belief. Kansas Water Well Contractor's License No. **585** This Water Well Record was completed on (mo/day/yr) **5-13-97** under the business name of **AEF** by (signature) *D. Duncan*

OFFICE USE ONLY T R E W SEC 1/4 1/4 1/4