

mw-1


1 LOCATION OF WATER WELL: County: **Labette** Fraction: **SW 1/4 NE 1/4 SW 1/4** Section Number: **34** Township Number: **T 34 S** Range Number: **R 21** **(E/W)**

Distance and direction from nearest town or city street address of well if located within city?
1039 maple, Chetopa, KS

2 WATER WELL OWNER: RR#, St. Address, Box #: **Carm 'n' Dales Attn: Dale Thomas** Board of Agriculture, Division of Water Resources
City, State, ZIP Code: **P.O. Box 61, Chetopa, Kansas 67336** Application Number: **-----**

3 LOCATE WELL'S LOCATION WITH AN "X" IN SECTION BOX:

4 DEPTH OF COMPLETED WELL: **14** ft. ELEVATION: **-----**

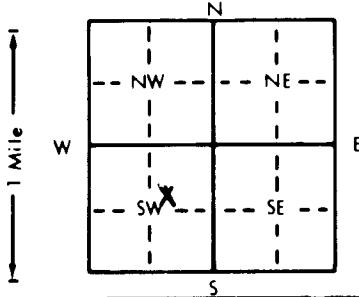

Depth(s) Groundwater Encountered: **1** ft. **2** ft. **3** ft.
WELL'S STATIC WATER LEVEL: **2.36** ft. below land surface measured on **mo/day/yr 5-29-97**
Pump test data: Well water was **-----** ft. after **-----** hours pumping **-----** gpm
Est. Yield **-----** gpm: Well water was **-----** ft. after **-----** hours pumping **-----** gpm
Bore Hole Diameter: **8.625** in. to **14** ft. and **-----** in. to **-----** ft.
WELL WATER TO BE USED AS: 5 Public water supply 8 Air conditioning 11 Injection well
1 Domestic 3 Feedlot 6 Oil field water supply 9 Dewatering 12 Other (Specify below)
2 Irrigation 4 Industrial 7 Lawn and garden only **10 Monitoring well mw-1**
Was a chemical/bacteriological sample submitted to Department? Yes **-----** No **X**; If yes, mo/day/yr sample was submitted **-----**
Water Well Disinfected? Yes **-----** No **X**

5 TYPE OF BLANK CASING USED: 1 Steel 3 RMP (SR) 5 Wrought iron 8 Concrete tile CASING JOINTS: Glued **-----** Clamped **-----**
2 PVC 4 ABS 6 Asbestos-Cement 9 Other (specify below) Welded **-----**
7 Fiberglass Threaded **X**

Blank casing diameter: **2** in. to **4** ft. Dia. **-----** in. to **-----** ft. Dia. **-----** in. to **-----** ft.
Casing height above land surface: **0** in. weight **SCH 40 PVC** lbs./ft. Wall thickness or gauge No. **-----**

TYPE OF SCREEN OR PERFORATION MATERIAL: 1 Steel 3 Stainless steel 5 Fiberglass 8 RMP (SR) 10 Asbestos-cement
2 Brass 4 Galvanized steel 6 Concrete tile 9 ABS 11 Other (specify) **-----**
12 None used (open hole)

SCREEN OR PERFORATION OPENINGS ARE: 1 Continuous slot 2 Mill slot 3 Mill slot 4 Key punched 5 Gauzed wrapped 6 Wire wrapped 7 Torch cut 8 Saw cut 9 Drilled holes 10 Other (specify) **-----**
11 None (open hole)

SCREEN-PERFORATED INTERVALS: From **4** ft. to **14** ft. From **-----** ft. to **-----** ft. From **-----** ft. to **-----** ft.
From **-----** ft. to **-----** ft. From **-----** ft. to **-----** ft. From **-----** ft. to **-----** ft.

GRAVEL PACK INTERVALS: From **3** ft. to **14** ft. From **-----** ft. to **-----** ft. From **-----** ft. to **-----** ft.
From **-----** ft. to **-----** ft. From **-----** ft. to **-----** ft. From **-----** ft. to **-----** ft.

6 GROUT MATERIAL: 1 Neat cement 2 Cement grout 3 Bentonite 4 Other **-----**
Grout Intervals: From **0** ft. to **1** ft. From **1** ft. to **3** ft. From **-----** ft. to **-----** ft. From **-----** ft. to **-----** ft.

What is the nearest source of possible contamination: 1 Septic tank 4 Lateral lines 7 Pit privy 10 Livestock pens 14 Abandoned water well
2 Sewer lines 5 Cess pool 8 Sewage lagoon 11 Fuel storage 15 Oil well/Gas well
3 Watertight sewer lines 6 Seepage pit 9 Feedyard 12 Fertilizer storage 16 Other (specify below) **UST contaminated site**
13 Insecticide storage

Direction from well? **-----** How many feet? **-----**

FROM	TO	LITHOLOGIC LOG	FROM	TO	PLUGGING INTERVALS
GL	0.50	Driveway gravel and clays			
	0.50	Silty Clay (CL)			
	4.00	Clayey Silt (ML)			
	14.00	End of Borehole			
	TD				

7 CONTRACTOR'S OR LANDOWNER'S CERTIFICATION: This water well was (1) constructed, (2) reconstructed, or (3) plugged under my jurisdiction and was completed on (mo/day/year) **5-7-97** and this record is true to the best of my knowledge and belief. Kansas Water Well Contractor's License No. **585** This Water Well Record was completed on (mo/day/yr) **5-13-97** under the business name of **AEI** by (signature) **D. Taylor**

INSTRUCTIONS: Use typewriter or ball point pen. PLEASE PRESS FIRMLY and PRINT clearly. Please fill in blanks, underline or circle the correct answers. Send top three copies to Kansas Department of Health and Environment, Bureau of Water, Topeka, Kansas 66620-0001. Telephone: 913-296-5545. Send one to WATER WELL OWNER and retain one for your records.

OFFICE USE ONLY
T
R
E/W
SEC.