


WATER WELL RECORD

Form WWC-5

Division of Water Resources App. No.

1 LOCATION OF WATER WELL: County: Labette	Fraction NE ¼ SE ¼ NW ¼ SE ¼	Section Number 34	Township No. T 34 S	Range Number R 21 <input checked="" type="checkbox"/> E <input type="checkbox"/> W
Street/Rural Address of Well Location; if unknown, distance & direction from nearest town or intersection: If at owner's address, check here <input type="checkbox"/> 527 Maple Street, Chetopa, Kansas		Global Positioning System (GPS) information: Latitude: .37.03727..... (in decimal degrees) Longitude: .95.09073..... (in decimal degrees) Elevation: .825.71..... Datum: <input type="checkbox"/> WGS 84, <input type="checkbox"/> NAD 83, <input type="checkbox"/> NAD 27 Collection Method: <input type="checkbox"/> GPS unit (Make/Model:) <input type="checkbox"/> Digital Map/Photo, <input type="checkbox"/> Topographic Map, <input checked="" type="checkbox"/> Land Survey Est. Accuracy: <input checked="" type="checkbox"/> <3 m, <input type="checkbox"/> 3-5 m, <input type="checkbox"/> 5-15 m, <input type="checkbox"/> >15 m		

2 WATER WELL OWNER: BP/Amoco Oil
RR#, Street Address, Box #: 1701 Summit Avenue
City, State, ZIP Code : Plano, Texas 75074

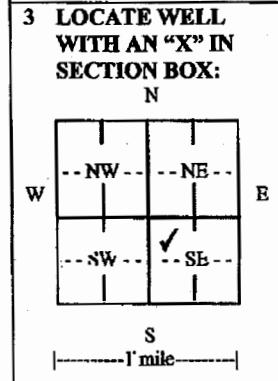

4 DEPTH OF COMPLETED WELL 19..... ft.
Depth(s) Groundwater Encountered (1) NA..... ft. (2) NA..... ft. (3) NA..... ft.
WELL'S STATIC WATER LEVEL 6.82..... ft. below land surface measured on mo/day/yr. 7/8/11.....
Pump test data: Well water was NA..... ft. after NA..... hours pumping NA..... gpm
EST. YIELD NA..... gpm. Well water was NA..... ft. after NA..... hours pumping NA..... gpm
Bore Hole Diameter 8.25..... in. to 19..... ft., and NA..... in. to NA..... ft.
WELL WATER TO BE USED AS: Public water supply Geothermal Injection well
 Domestic Feedlot Oil field water supply Dewatering Other (Specify below)
 Irrigation Industrial Domestic-lawn & garden Monitoring well MWV-2.....
Was a chemical/bacteriological sample submitted to Department? Yes No
If yes, mo/day/yr sample was submitted NA.....
Water well disinfected? Yes No

5 TYPE OF CASING USED: Steel PVC Other.....
CASING JOINTS: Glued Clamped Welded Threaded
Casing diameter 2..... in. to 3..... ft., Diameter NA..... in. to NA..... ft., Diameter NA..... in. to NA..... ft.
Casing height above land surface 0..... in., Weight NA..... lbs./ft., Wall thickness or gauge No. Schedule 40.....
TYPE OF SCREEN OR PERFORATION MATERIAL:
 Steel Stainless Steel PVC Other (Specify)
 Brass Galvanized Steel None used (open hole)
SCREEN OR PERFORATION OPENINGS ARE:
 Continuous slot Mill slot Gauze wrapped Torch cut Drilled holes None (open hole)
 Louvered shutter Key punched Wire wrapped Saw cut Other (specify)
SCREEN-PERFORATED INTERVALS: From 3..... ft. to 19..... ft., From NA..... ft. to NA..... ft.
From NA..... ft. to NA..... ft., From NA..... ft. to NA..... ft.
GRAVEL PACK INTERVALS: From 2.5..... ft. to 19..... ft., From NA..... ft. to NA..... ft.
From NA..... ft. to NA..... ft., From NA..... ft. to NA..... ft.

6 GROUT MATERIAL: Neat cement Cement grout Bentonite Other Concrete 0 to 0.5 feet
Grout Intervals: From 0.5..... ft. to 2.5..... ft., From NA..... ft. to NA..... ft., From NA..... ft. to NA..... ft.
What is the nearest source of possible contamination:
 Septic tank Lateral lines Pit privy Livestock pens Insecticide storage Other (specify below)
 Sewer lines Cesspool Sewage lagoon Fuel storage Abandoned water well
 Watertight sewer lines Seepage pit Feedyard Fertilizer storage Oil well/gas well.....
Direction from well Distance from well

FROM	TO	LITHOLOGIC LOG	FROM	TO	LITHO. LOG (cont.) or PLUGGING INTERVALS
0	5	Silty CLAY			
5	14	Fat CLAY			
14	19	Sandstone			

7 CONTRACTOR'S OR LANDOWNER'S CERTIFICATION: This water well was constructed, reconstructed, or plugged under my jurisdiction and was completed on (mo/day/year) 7/7/2011..... and this record is true to the best of my knowledge and belief. Kansas Water Well Contractor's License No. 759..... This Water Well Record was completed on (mo/day/year) 7/28/2011..... under the business name of RAZEK Environmental, LLC..... by (signature) *[Signature]*

INSTRUCTIONS: Use typewriter or ball point pen. PLEASE PRESS FIRMLY and PRINT clearly. Please fill in blanks and check the correct answers. Send three copies (white, blue, pink) to Kansas Department of Health and Environment, Bureau of Water, Geology Section, 1000 SW Jackson St., Suite 420, Topeka, Kansas 66612-1367. Telephone 785-296-5522. Send one copy to WATER WELL OWNER and retain one for your records. Include fee of \$5.00 for each constructed well. Visit us at <http://www.kdheks.gov/waterwell/index.html>.