

(DRL KGS)

## WATER WELL PLUGGING RECORD

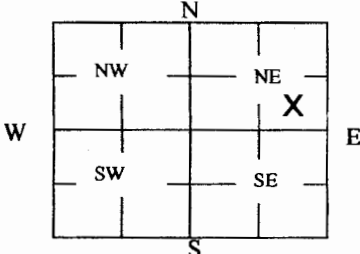
Form WWC-5P

KSA 82a-1212

ID NO.

1 LOCATION OF WATER WELL: County: <u>Cherokee</u>	Fraction $\frac{1}{4}$ <u>SW <math>\frac{1}{4}</math> NE <math>\frac{1}{4}</math></u>	Section Number <u>34</u>	Township Number T <u>34</u> S	Range Number <u>24</u> <input checked="" type="checkbox"/> E <input type="checkbox"/> W
Street/Rural Address of Well Location; if unknown, distance & direction from nearest town or intersection: If at owner's address, check here <input checked="" type="checkbox"/> <u>Josh + Julie Egermeier</u> <u>595 N. Ballard Ave</u> <u>Baxter Springs, KS 66713</u>		Global Positioning Systems (GPS) information: Latitude: <u>37.04132</u> (in decimal degrees) Longitude: <u>-94.75885</u> (in decimal degrees) Elevation: <u>794 ft</u> Horizontal Datum: <input type="checkbox"/> WGS84, <input type="checkbox"/> NAD83, <input type="checkbox"/> NAD27 Collection Method: <input checked="" type="checkbox"/> GPS unit (Make/Model: <u>Trimble Juno 3D</u> ) <input type="checkbox"/> Digital Map/Photo, <input type="checkbox"/> Topographic Map, <input type="checkbox"/> Land Survey Est. Accuracy: <input type="checkbox"/> < 3 m, <input type="checkbox"/> 3-5 m, <input type="checkbox"/> 5-15 m, <input type="checkbox"/> > 15 m		
2 WATER WELL OWNER: <u>Josh + Julie Egermeier</u> RR#, St. Address, Box #: <u>595 N. Ballard Ave.</u> City, State ZIP Code: <u>Baxter Springs, KS 66713</u>				

(DRL KGS)

3 MARK WELL'S LOCATION WITH AN "X" IN SECTION BOX: 	4 DEPTH OF WELL <u>20</u> ft. WELL'S STATIC WATER LEVEL <u>3.0</u> ft WELL WAS USED AS: <input checked="" type="checkbox"/> Domestic <input type="checkbox"/> Public Water Supply <input type="checkbox"/> Dewatering <input type="checkbox"/> Irrigation <input type="checkbox"/> Oil Field Water Supply <input type="checkbox"/> Monitoring <input type="checkbox"/> Feedlot <input type="checkbox"/> Domestic (Lawn & Garden) <input type="checkbox"/> Injection Well <input type="checkbox"/> Industrial <input type="checkbox"/> Air Conditioning <input type="checkbox"/> Other _____ Was a chemical/bacteriological sample submitted to Department? Yes <input type="checkbox"/> No <input checked="" type="checkbox"/>
---	---

5 TYPE OF BLANK CASING USED:

☐ Steel ☐ RMP (SR) ☐ Wrought ☐ Fiberglass ☒ Other (Specify below)  
☐ PVC ☐ ABS ☐ Asbestos-Cement ☐ Concrete Tile Hand dug/Stone lined

Blank casing diameter \_\_\_\_\_ in. Was casing pulled? Yes ☐ No ☒ If yes, how much N/A  
 Casing height above or below land surface \_\_\_\_\_ in.

6 GROUT PLUG MATERIAL: ☐ Neat cement ☒ Cement grout ☒ Bentonite ☒ Other Clay soil

Grout Plug Intervals: From 20 ft. to 2.4 ft., From 2.4 ft. to 1.4 ft., From 1.4 ft. to 0 ft.

What is the nearest source of possible contamination:  
☒ Septic tank ☐ Seepage pit ☐ Fuel storage ☐ Other (specify below)  
☐ Sewer lines ☐ Pit privy ☐ Fertilizer storage  
☐ Watertight sewer lines ☐ Sewage lagoon ☐ Insecticide storage  
☐ Lateral lines ☐ Feedyard ☐ Abandoned water well  
☐ Cess pool ☐ Livestock pens ☐ Oil well/Gas well  
 Direction from well? West  
 How many feet? >200 feet

FROM	TO	PLUGGING MATERIALS	FROM	TO	PLUGGING MATERIALS
20 ft	2.4 ft	Hydrated bentonite			
2.4 ft	1.4 ft	Cement grout			
1.4 ft	0 ft	Clay soil			

7 CONTRACTOR'S OR LANDOWNER'S CERTIFICATION: This water well was plugged under my jurisdiction and was completed on (mo/day/year) May 18, 2018 and this record is true to the best of my knowledge and belief. Kansas Water Well Contractor's License No. N/A. This Water Well Record was completed on (mo/day/year) 07/02/2018 under the business name of N/A (Property Owner) by (signature) Julie Egermeier

Send one copy to Kansas Department of Health & Environment, Geology Section, 1000 SW Jackson Street, Ste. 420, Topeka, KS 66612-1367. Send one copy to WATER WELL OWNER and retain one for your records.

APR 26 2019

Visit us at <http://www.kdheks.gov/waterwell/index.html>

Telephone 785-296-5524.

KSA82a-1212

Revised 1/20/2015

BUREAU OF WATER