


1) LOCATION OF WATER WELL: County: Cherokee	Fraction SW 1/4 SW 1/4 SE 1/4	Section Number 32	Township Number T 34 S	Range Number R 24 EW
Distance and direction from nearest town or city street address of well if located within city?				

RR#, St. Address, Box # : Land Owner: Ron Stoskoph
City, State, ZIP Code : Mine Lease: Ron Stoskoph

Application Number:

4 DEPTH OF COMPLETED WELL... 1001.00 ... ft. ELEVATION:

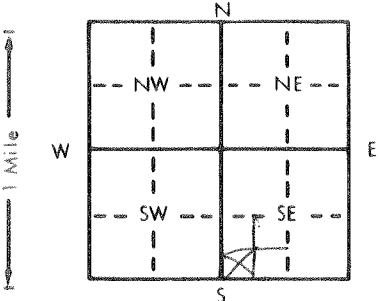

4. DEPTH OF COMPLETED WELL... <u>1001.00</u> ft. ELEVATION:	
Depth(s) Groundwater Encountered	1. ft. 2. ft. 3. ft.
WELL'S STATIC WATER LEVEL ft. below land surface measured on mo/day/yr	
Pump test data: Well water was ft. after hours pumping gpm	
Est. Yield gpm:	Well water was ft. after hours pumping gpm
Bore Hole Diameter, in. to ft., and, in. to ft.	
WELL WATER TO BE USED AS:	
5 Public water supply	8 Air conditioning
11 Injection well	
1 Domestic	3 Feedlot
6 Oil field water supply	9 Dewatering
12 Other (Specify below)	
2 Irrigation	4 Industrial
7 Lawn and garden only	10 Observation well
Was a chemical/bacteriological sample submitted to Department? Yes.....No.....; If yes, mo/day/yr sample was submitted	
Water Well Disinfected? Yes No	

1 Steel	3 RMP (SR)
2 PVC	4 ABS

5 Wrought iron	8 Concrete tile
6 Asbestos-Cement	9 Other (specify below)
7 Fiberglass

CASING JOINTS: Glued Clamped
Welded
. Threaded.

Blank casing diameter in. to ft., Dia in. to ft., Dia in. to ft.
Casing height above land surface in., weight lbs./ft. Wall thickness or gauge No.

TYPE OF SCREEN OR PERFORATION MATERIAL:

1 Steel	3 Stainless steel	5 Fiberglass	8 RMP (SR)	11 Other (specify)
2 Brass	4 Galvanized steel	6 Concrete tile	9 ABS	12 None used (open hole)

SCREEN OR PERFORATION OPENINGS ARE:

1 Continuous slot	3 Mill slot	6 Wire wrapped	9 Drilled holes
2 Louvered shutter	4 Key punched	7 Torch cut	10 Other (specify)

SCREEN-PERFORATED INTERVALS: From ft. to ft., From ft. to ft.
 From ft. to ft., From ft. to ft.
 GRAVEL PACK INTERVALS: From ft. to ft., From ft. to ft.
 From ft. to ft., From ft. to ft.

6 GROUT MATERIAL: 1 Neat cement 2 Cement grout 3 Bentonite 4 Other Pea gravel T.D. to 900 ft.
Grout Intervals: From -900 ft. to surface ft. From _____ ft. to _____ ft. From _____ ft. to _____ ft.

What is the nearest source of possible contamination:

1 Septic tank	4 Lateral lines	7 Pit privy	11 Fuel storage	15 Oil well/Gas well
2 Sewer lines	5 Cess pool	8 Sewage lagoon	12 Fertilizer storage	16 Other (specify below)
3 Watertight sewer lines	6 Seepage pit	9 Feedyard	13 Insecticide storage

Direction from well?

How many feet?

[illegible]

7 CONTRACTOR'S OR LANDOWNER'S CERTIFICATION: This water well was (1) constructed, (2) reconstructed, or (3) plugged under my jurisdiction and was completed on (mo/day/year) 8-12-86 and this record is true to the best of my knowledge and belief. Kansas

Water Well Contractor's License No. 474 This Water Well Record was completed on (mo/day/yr) 8-12-86
under the business name of Williams Water Well Co. by (signature) William Williams

INSTRUCTIONS: Use typewriter or ball point pen, PLEASE PRESS FIRMLY and PRINT clearly. Please fill in blanks, underline or circle the correct answers. Send top three copies to Kansas Department of Health and Environment, Division of Environment, Environmental Geology Section, Topeka, KS 66620. Send one to WATER WELL OWNER and retain one for your records.