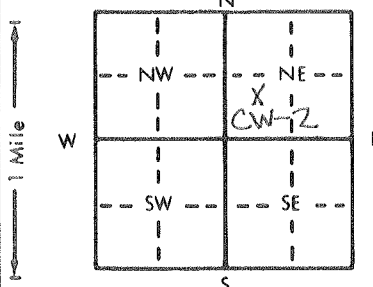


1 LOCATION OF WATER WELL: County: Cherokee Fraction: NW 1/4 SW 1/4 NE 1/4 Section Number: 4 Township Number: T 34 S Range Number: R 25E EW

Distance and direction from nearest town or city street address of well if located within city?
3 MILES NORTH OF RIVERTON, KS - EAST OF ALT. 69 HWY - JAYHAWK PLANT Well #: CW-2

2 WATER WELL OWNER: Chevron Chemical Company
 RR#, St. Address, Box #: 6001 Bollinger Canyon Rd. Board of Agriculture, Division of Water Resources
 City, State, ZIP Code: Box 5047 San Ramon, CA 94583 Application Number:

3 LOCATE WELL'S LOCATION WITH AN "X" IN SECTION BOX:


4 DEPTH OF COMPLETED WELL: 470 ft. ELEVATION: 835.25
 Depth(s) Groundwater Encountered 1. ft. 2. ft. 3. ft.
 WELL'S STATIC WATER LEVEL: 83.7 ft. below land surface measured on mo/day/yr 7/21/95
 Pump test data: Well water was ft. after hours pumping gpm
 Est. Yield gpm: Well water was ft. after hours pumping gpm
 Bore Hole Diameter: 17.5 in. to 28.25 ft., and 12.4 in. to 305 ft. 8" TO 470'
 WELL WATER TO BE USED AS: 5 Public water supply 8 Air conditioning 11 Injection Well
 1 Domestic 3 Feedlot 6 Oil field water supply 9 Dewatering 12 Other (Specify below)
 2 Irrigation 4 Industrial 7 Lawn and garden only 10 Monitoring well ~~11~~
 Was a chemical/bacteriological sample submitted to Department? Yes.....No...X.....; If yes, mo/day/yr sample was submitted
 Water Well Disinfected? Yes No X

5 TYPE OF BLANK CASING USED: 5 Wrought iron 8 Concrete tile CASING JOINTS: Glued Clamped
1 Steel 3 RMP (SR) 6 Asbestos-Cement 9 Other (specify below) Welded X
 2 PVC 4 ABS 7 Fiberglass Threaded.....
 Blank casing diameter: 14 in. to 25 ft., Dia. 8 in. to 305 ft., Dia. in. to ft.
 Casing height above land surface: 30 in., weight 28.55 lbs./ft. Wall thickness or gauge No. 0.322"
 TYPE OF SCREEN OR PERFORATION MATERIAL: 7 PVC 10 Asbestos-cement
 1 Steel 3 Stainless steel 5 Fiberglass 8 RMP (SR) 11 Other (specify)
 2 Brass 4 Galvanized steel 6 Concrete tile 9 ABS 12 None used (open hole)
 SCREEN OR PERFORATION OPENINGS ARE: 5 Gauzed wrapped 8 Saw cut 11 None (open hole)
 1 Continuous slot 3 Mill slot 6 Wire wrapped 9 Drilled holes
 2 Louvered shutter 4 Key punched 7 Torch cut 10 Other (specify)

SCREEN-PERFORATED INTERVALS: From ft. to ft., From ft. to ft.
 From ft. to ft., From ft. to ft.
 GRAVEL PACK INTERVALS: From ft. to ft., From ft. to ft.
 From ft. to ft., From ft. to ft.

6 GROUT MATERIAL: 1 Neat cement 2 Cement grout 3 Bentonite 4 Other
 Grout Intervals: From 0 ft. to 305 ft., From ft. to ft., From ft. to ft.
 What is the nearest source of possible contamination:
 1 Septic tank 4 Lateral lines 7 Pit privy 10 Livestock pens 14 Abandoned water well
 2 Sewer lines 5 Cess pool 8 Sewage lagoon 11 Fuel storage 15 Oil well/Gas well
 3 Watertight sewer lines 6 Seepage pit 9 Feedyard 12 Fertilizer storage 16 Other (specify below)
Jayhawk Plant

Direction from well? Well Located on Jayhawk Plant Property How many feet?

FROM	TO	LITHOLOGIC LOG	FROM	TO	PLUGGING INTERVALS
0	10	Clay			
10	25	Limestone			
25	292	Cherty Dolomite			
292	305	Shale			
305	385	Shale and Limestone			
385	460	Cherty Dolomite			
460	470	Limestone			

7 CONTRACTOR'S OR LANDOWNER'S CERTIFICATION: This water well was 1 constructed, (2) reconstructed, or (3) plugged under my jurisdiction and was completed on (mo/day/year) 11/16/95 and this record is true to the best of my knowledge and belief. Kansa Water Well Contractor's License No. 102 This Water Well Record was completed on (mo/day/yr) 11-16-95 under the business name of Layne-Western by (signature) [Signature]

INSTRUCTIONS: Use typewriter or ball point pen. PLEASE PRESS FIRMLY and PRINT clearly. Please fill in blanks, underline or circle the correct answers. Send top three copies to Kansas Department of Health and Environment, Bureau of Water, Topeka, Kansas 66620-0001. Telephone: 913-296-5545. Send one to WATER WELL OWNER and retain one for your records.