

CORRECTION(S) TO WATER WELL RECORD (WWC-5)

(to rectify lacking or incorrect information)

County: Cherokee

Location listed as:

Section-Township-Range: 20 - 34 - 35 E

Fraction (  $\frac{1}{4}$   $\frac{1}{4}$   $\frac{1}{4}$ ): NE

Location changed to:

20 - 34 S - 25 E

NE NW NW

Other changes: Initial statements: \_\_\_\_\_

Changed to: \_\_\_\_\_

Comments: \_\_\_\_\_

verification method: Well address, city street map, and mapping tool on KGS website.


initials: WRD date: 9/29/2006

submitted by: Kansas Geological Survey, Data Resources Library, 1930 Constant Ave., Lawrence, KS 66047-3726  
to: Kansas Dept of Health & Environment, Bureau of Water, 1000 SW Jackson, Suite 420, Topeka, KS 66612-1367.

**1 LOCATION OF WATER WELL:** Fraction  $\frac{1}{4}$   $\frac{1}{4}$  NE  $\frac{1}{4}$  Section Number 20 Township Number 34 Range Number 35 EW  
 County: CHEROKEE

Distance and direction from nearest town or city street address of well if located within city?  
AT 7240 SE HIGHWAY 66, Riverton KS

**2 WATER WELL OWNER:** EMPIRE DIST. Elect. Co Global Positioning Systems (decimal degrees, min. of 4 digits)  
 RR#, St. Address, Box #: 602 Joplin Street Latitude: \_\_\_\_\_  
 City, State ZIP Code: Joplin, MO 64801 Longitude: \_\_\_\_\_  
 Elevation: T.O.C. of MW-3 = 828.82 Datum: \_\_\_\_\_  
 Data Collection Method: \_\_\_\_\_

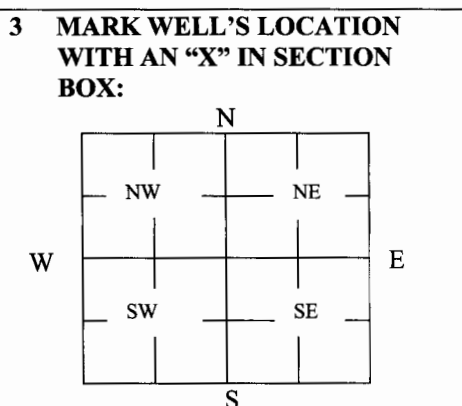

**4 DEPTH OF WELL** 40 ft. I.D. MW-3  
 WELL'S STATIC WATER LEVEL 15 ft T.O.C.  
 WELL WAS USED AS: 10

1 Domestic	5 Public Water Supply	9 Dewatering
2 Irrigation	6 Oil Field Water Supply	<u>10 Monitoring</u>
3 Feedlot	7 Domestic (Lawn & Garden)	11 Injection Well
4 Industrial	8 Air Conditioning	12 Other _____

Was a chemical/bacteriological sample submitted to Department? Yes \_\_\_\_\_ No \_\_\_\_\_

**5 TYPE OF BLANK CASING USED:**

1 Steel	3 RMP (SR)	5 Wrought	7 Fiberglass	9 Other (Specify below)
2 PVC	4 ABS	6 Asbestos-Cement	8 Concrete Tile	<u>NO CASING</u>

Blank casing diameter \_\_\_\_\_ in. Was casing pulled? Yes \_\_\_\_\_ No \_\_\_\_\_ If yes, how much \_\_\_\_\_  
 Casing height above or below land surface \_\_\_\_\_ in. NOTE: BOTH 2-INCH PVC SCREEN (10') & RISER (30') were removed.

**6 GROUT PLUG MATERIAL:** 1 Neat cement 2 Cement grout 3 Bentonite 4 Other \_\_\_\_\_  
 Grout Plug Intervals: From 40 ft. to 1 ft., From \_\_\_\_\_ ft. to \_\_\_\_\_ ft., From \_\_\_\_\_ to \_\_\_\_\_ ft.

What is the nearest source of possible contamination:

1 Septic tank	6 Seepage pit	11 Fuel Storage	16 Other (specify below)
2 Sewer lines	7 Pit privy	12 Fertilizer storage	<u>Settling ASH Pond</u>
3 Watertight sewer lines	8 Sewage lagoon	13 Insecticide storage	
4 Lateral lines	9 Feedyard	14 Abandoned water well	Direction from well? <u>NORTH</u>
5 Cess pool	10 Livestock pens	15 Oil well/Gas well	How many feet? <u>5</u>

FROM	TO	PLUGGING MATERIALS	FROM	TO	PLUGGING MATERIALS
<u>40</u>	<u>1</u>	<u>Bentonite</u>			
<u>1</u>	<u>0</u>	<u>Gravel</u>			
<b>OTHER NOTE:</b> <u>The protective steel flush-mount cover &amp; concrete were also removed.</u>					
<u>MISSOURI</u>					

**7 CONTRACTOR'S OR LANDOWNER'S CERTIFICATION:** This water well was plugged under my jurisdiction and was completed on (mo/day/year) 8-15-06 and this record is true to the best of my knowledge and belief. Kansas Water Well Contractor's License No. 3857M. This Water Well Record was completed on (mo/day/year) 8-22-06 under the business name of Midwest Environmental Consultants by (signature) Richard J. Elgin