


WATER WELL PLUGGING RECORD Form WWC-5P83-A KSA 82a-1212 ID NO.

| | | | | |
|--|--------------------------------------|----------------------|---------------------------|---|
| 1 LOCATION OF WATER WELL: County: Cherokee | Fraction NW 1/4 SE 1/4 NW 1/4 1/4 | Section Number 20 | Township Number T 34 S | Range Number 25 <input checked="" type="checkbox"/> E <input type="checkbox"/> W |
|--|--------------------------------------|----------------------|---------------------------|---|

| | |
|---|---|
| Street/Rural Address of Well Location; if unknown, distance & direction from nearest town or intersection: If at owner's address, check here <input type="checkbox"/> CCW Impoundment Levee Riverton Power Station, 7240 SE Hwy 66, Riverton, KS | Global Positioning Systems (GPS) information: Latitude: 37.0683 (in decimal degrees) Longitude: 94.6996 (in decimal degrees) Elevation: ^{827.9} Datum: <input type="checkbox"/> WGS84, <input checked="" type="checkbox"/> NAD83, <input type="checkbox"/> NAD27 Collection Method: <input checked="" type="checkbox"/> GPS unit (Make/Model: _____) <input type="checkbox"/> Digital Map/Photo, <input type="checkbox"/> Topographic Map, <input checked="" type="checkbox"/> Land Survey Est. Accuracy: <input checked="" type="checkbox"/> < 3 m, <input type="checkbox"/> 3-5 m, <input type="checkbox"/> 5-15 m, <input type="checkbox"/> > 15 m |
|---|---|

2 WATER WELL OWNER: Empire District Electric
 RR#, St. Address, Box #: P.O. Box 127
 City, State ZIP Code: Joplin, MO 64802

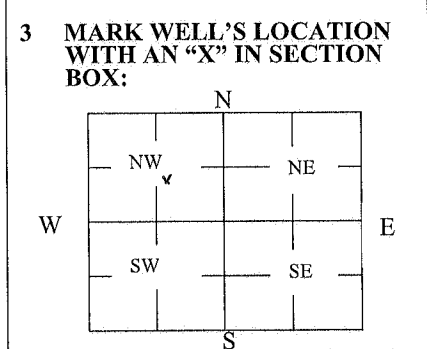

4 DEPTH OF WELL 32 ft.
 WELL'S STATIC WATER LEVEL 12.5 ft
 WELL WAS USED AS:
 Domestic Public Water Supply Dewatering
 Irrigation Oil Field Water Supply Monitoring
 Feedlot Domestic (Lawn & Garden) Injection Well
 Industrial Air Conditioning Other Piezometer
 Was a chemical/bacteriological sample submitted to Department? Yes No

5 TYPE OF BLANK CASING USED:

Steel RMP (SR) Wrought Fiberglass Other (Specify below) _____
 PVC ABS Asbestos-Cement Concrete Tile

Blank casing diameter 2 in. Was casing pulled? Yes No If yes, how much Full Depth
 Casing height above or below land surface NA in.

6 GROUT PLUG MATERIAL: Neat cement Cement grout Bentonite Other _____

Grout Plug Intervals: From 3 ft. to 32 ft., From _____ ft. to _____ ft., From _____ to _____ ft.

What is the nearest source of possible contamination:
 Septic tank Seepage pit Fuel Storage Other (specify below) CCW Impoundment
 Sewer lines Pit privy Fertilizer storage
 Watertight sewer lines Sewage lagoon Insecticide storage
 Lateral lines Feedyard Abandoned water well Oil well/Gas well
 Cess pool Livestock pens

Direction from well? West
 How many feet? 5 ft.

| FROM | TO | PLUGGING MATERIALS | FROM | TO | PLUGGING MATERIALS |
|------|----|----------------------------------|------|----|--------------------|
| 0 | 3 | Bentonite Chips | | | |
| 3 | 32 | Cement Grout w/ Bentonite Powder | | | |
| | | | | | |
| | | | | | |
| | | | | | |
| | | | | | |

7 CONTRACTOR'S OR LANDOWNER'S CERTIFICATION: This water well was p lugged under my jurisdiction and was completed on (mo/day/year) 6/10-11/13 and this record is true to the best of my knowledge and belief. Kansas Water Well Contractor's License No. 754. This Water Well Record was completed on (mo/day/year) 6/24/13 under the business name of Palmerton & Parrish, Inc. by (signature) [Signature]

INSTRUCTIONS: Use typewriter or ballpoint pen. Please press firmly and print clearly. Please fill in blanks, underline or circle the correct answers. Send one copy to Kansas Department of Health and Environment, Bureau of Water, Geology Section, 1000 SW Jackson St., Ste. 420, Topeka, Kansas 66612-1367. Telephone: 785/296-5524. Send one to Water Well Owner and retain one for your records. Visit us at <http://www.kdheks.gov/waterwell/index.html>.