


1	LOCATION OF WATER WELL:	Fraction	Section Number	Township Number	Range Number
	County: <u>Cherokee</u>	<u>SE</u> $\frac{1}{4}$ <u>NE</u> $\frac{1}{4}$ <u>NE</u> $\frac{1}{4}$	<u>14</u>	T <u>34</u> S	R <u>25</u> E/W

Exlent Mar 10 AT 7

RR#, St. Address, Box # :
City, State, ZIP Code : Williams #1

Application Number:

Z

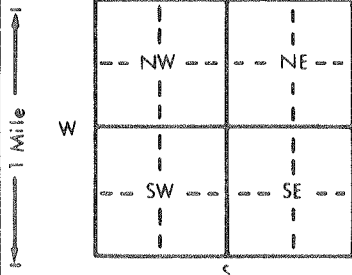

mitted	Water Well Disinfected? Yes	No
--------	-----------------------------	----

How many feet? 300

All the above missing info 05-93