


1 LOCATION OF WATER WELL:	Fraction	Section Number	Township Number	Range Number
County: <u>CHEROKEE</u>	<u>SW</u> $\frac{1}{4}$ <u>SW</u> $\frac{1}{4}$ SW $\frac{1}{4}$	19	T 34 S	R 25 <u>EW</u>

3/4 Mile SW of Riverton, Kansas

LOCATE WELL'S LOCATION WITH AN "X" IN SECTION BOX:

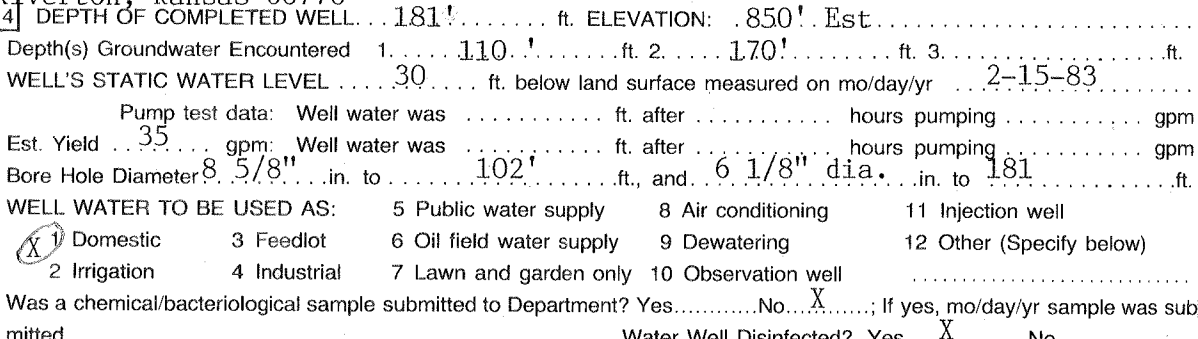

Blank casing diameter .. 6.5/8" .. in. to .. 102 .. ft., Dia .. in. to .. ft., Dia .. in. to .. ft.
Casing height above land surface .. 12 .. in., weight .. 13 .. lbs./ft. Wall thickness or gauge No. .. 188 wall ..

1 Continuous slot	3 Mill slot	6 Wire wrapped	9 Drilled holes
2 Louvered shutter	4 Key punched	7 Torch cut	10 Other (specify)

GRAVEL PACK INTERVALS: From ft. to ft., From ft. to ft.
From ft. to ft., From ft. to ft.

1 Septic tank	4 Lateral lines	7 Pit, privy	11 Fuel storage	15 Oil well/Gas well
2 Sewer lines	5 Cess pool	8 Sewage lagoon	12 Fertilizer storage	16 Other (specify below)
3 Watertight sewer lines	6 Seepage pit	9 Feedyard	13 Insecticide storage	

FROM	TO	LITHOLOGIC LOG	FROM	TO	LITHOLOGIC LOG
------	----	----------------	------	----	----------------

[illegible]

INSTRUCTIONS: Use typewriter or ball point pen, PLEASE PRESS FIRMLY and PRINT clearly. Please fill in blanks, underline or circle the correct answers. Send top copies to Kansas Department of Health and Environment, Division of Environment, Environmental Geology Section, Topeka, KS 66620. Send one to WATER WELL and retain one for your records.