K9418 WATER WELL RECORD Form WWC-5 KSA 82a-1212 MW A2 R0

1 LOCATION OF WATER WELL: County: Cherokee 011 | Fraction: SE ¼ NW ¼ NE ¼ | Section Number: 4 | Township Number: T 34 S | Range Number: R 25 E/W

Distance and direction from nearest town or city street address of well if located within city?
3 miles Northeast of Riverton, KS

2 WATER WELL OWNER: Malcolm Pirnie INC
RR#, St. Address, Box # : 102 Corporate Park, Drive
City, State, ZIP Code : White Plains, NY 10602
Board of Agriculture, Division of Water Resource
Application Number:

3 LOCATE WELL'S LOCATION WITH AN "X" IN SECTION BOX:

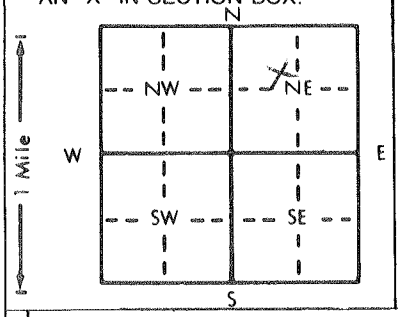

4 DEPTH OF COMPLETED WELL 51.5 ft. ELEVATION: 856
Depth(s) Groundwater Encountered 1. 9.5 E ft. 2. ft. 3. ft.
WELL'S STATIC WATER LEVEL 8.5 ft. below land surface measured on mo/day/yr 12-29-94
Pump test data: Well water was ft. after hours pumping gpm
Est. Yield 21 gpm: Well water was ft. after hours pumping gpm
Bore Hole Diameter 8 in. to 9 ft., and 6 in. to 41 ft.
WELL WATER TO BE USED AS: 5 Public water supply 8 Air conditioning 11 Injection well
1 Domestic 3 Feedlot 6 Oil field water supply 9 Dewatering 12 Other (Specify below)
2 Irrigation 4 Industrial 7 Lawn and garden only (10) Monitoring well
Was a chemical/bacteriological sample submitted to Department? Yes ..... No ✓; If yes, mo/day/yr sample was submitted
Water Well Disinfected? Yes No ✓

5 TYPE OF BLANK CASING USED: 5 Wrought iron 8 Concrete tile CASING JOINTS: Glued Clamped
1 Steel 3 RMP (SR) 6 Asbestos-Cement 9 Other (specify below) Welded
(2) PVC 4 ABS 7 Fiberglass Threaded ✓
Blank casing diameter 4 in. to 41 ft., Dia in. to ft., Dia in. to ft.
Casing height above land surface 24 in., weight 2.8 lbs./ft. Wall thickness or gauge No. Sch. 80

TYPE OF SCREEN OR PERFORATION MATERIAL: 7 PVC 10 Asbestos-cement
1 Steel 3 Stainless steel 5 Fiberglass 8 RMP (SR) 11 Other (specify)
2 Brass 4 Galvanized steel 6 Concrete tile 9 ABS (12) None used (open hole)

SCREEN OR PERFORATION OPENINGS ARE: 5 Gauzed wrapped 8 Saw cut (11) None (open hole)
1 Continuous slot 3 Mill slot 6 Wire wrapped 9 Drilled holes
2 Louvered shutter 4 Key punched 7 Torch cut 10 Other (specify)

SCREEN-PERFORATED INTERVALS: From ft. to ft., From ft. to ft.
From ft. to ft., From ft. to ft.
GRAVEL PACK INTERVALS: From ft. to ft., From ft. to ft.
From ft. to ft., From ft. to ft.

6 GROUT MATERIAL: (1) Neat cement 2 Cement grout (3) Bentonite 4 Other
Grout Intervals: From 0 ft. to 39 ft., From 39 ft. to 41 ft., From ft. to ft.
What is the nearest source of possible contamination:
1 Septic tank 4 Lateral lines 7 Pit privy 10 Livestock pens 14 Abandoned water well
2 Sewer lines 5 Cess pool 8 Sewage lagoon 11 Fuel storage 15 Oil well/Gas well
3 Watertight sewer lines 6 Seepage pit 9 Feedyard 12 Fertilizer storage 16 Other (specify below)
13 Insecticide storage Industrial Sites/Area
Direction from well? Wells Located on IND. Site How many feet? N/A

FROM	TO	LITHOLOGIC LOG	FROM	TO	PLUGGING INTERVALS
0	8	Silty & Sandy CLAY			
8	9	Gravelly CLAY			
9	17	CHERT			
17		LIMESTONE			
					X 3' to 51.5'

7 CONTRACTOR'S OR LANDOWNER'S CERTIFICATION: This water well was (1) constructed, (2) reconstructed, or (3) plugged under my jurisdiction and was completed on (mo/day/year) 1-6-95 and this record is true to the best of my knowledge and belief. Kansas Water Well Contractor's License No. 399 This Water Well Record was completed on (mo/day/yr) 2-28-95
under the business name of Woodward-Clyde Consultants by (signature) Richard A. Nichols

INSTRUCTIONS: Use typewriter or ball point pen. *PLEASE PRESS FIRMLY* and *PRINT* clearly. Please fill in blanks, underline or circle the correct answers. Send top three copies to Kansas Department of Health and Environment, Bureau of Water, Topeka, Kansas 66620-0001. Telephone: 913-296-5545. Send one to WATER WELL OWNER and retain one for your records.