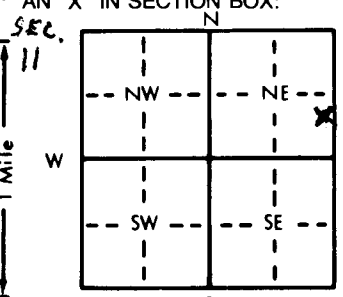


Copy - HP

1 LOCATION OF WATER WELL: Fraction NE 1/4 SE 1/4 NE 1/4 Section Number 11 Township Number T 34 S Range Number R 3 **EW**  
 County: COWLEY Distance and direction from nearest town or city street address of well if located within city?

1 WEST + 2 1/2 NORTH OF ARKANSAS CITY

2 WATER WELL OWNER: STEVE LONG  
 RR#, St. Address, Box #: R#2 Board of Agriculture, Division of Water Resources  
 City, State, ZIP Code: ARKANSAS CITY, KANSAS 67005 Application Number:

3 LOCATE WELL'S LOCATION WITH AN "X" IN SECTION BOX:  
  
 4 DEPTH OF COMPLETED WELL: 32' ft. ELEVATION:  
 Depth(s) Groundwater Encountered 1. 20' ft. 2. ft. 3. ft.  
 WELL'S STATIC WATER LEVEL: 20' ft. below land surface measured on mo/day/yr  
 Pump test data: Well water was ft. after hours pumping gpm  
 Est. Yield gpm: Well water was ft. after hours pumping gpm  
 Bore Hole Diameter: 5" in. to 32' ft., and in. to ft.  
 WELL WATER TO BE USED AS:  
 1 Domestic 3 Feedlot 6 Oil field water supply 9 Dewatering 12 Other (Specify below)  
 2 Irrigation 4 Industrial 7 Lawn and garden only 10 Observation well  
 Was a chemical/bacteriological sample submitted to Department? Yes No X; If yes, mo/day/yr sample was submitted  
 Water Well Disinfected? Yes No X

5 TYPE OF BLANK CASING USED:  
 1 Steel 3 RMP (SR) 5 Wrought iron 8 Concrete tile CASING JOINTS: Glued X Clamped  
 2 PVC X 4 ABS 6 Asbestos-Cement 9 Other (specify below) Welded  
 7 Fiberglass Threaded  
 Blank casing diameter 2" in. to ft., Dia in. to ft., Dia in. to ft.  
 Casing height above land surface 2' in., weight 200# PVC lbs./ft. Wall thickness or gauge No.  
 TYPE OF SCREEN OR PERFORATION MATERIAL:  
 1 Steel 3 Stainless steel 5 Fiberglass 7 PVC X 10 Asbestos-cement  
 2 Brass 4 Galvanized steel 6 Concrete tile 8 RMP (SR) 11 Other (specify)  
 9 ABS 12 None used (open hole)  
 SCREEN OR PERFORATION OPENINGS ARE:  
 1 Continuous slot 3 Mill slot 5 Gauzed wrapped 8 Saw cut X 11 None (open hole)  
 2 Louvered shutter 4 Key punched 6 Wire wrapped 9 Drilled holes  
 7 Torch cut 10 Other (specify)  
 SCREEN-PERFORATED INTERVALS: From 20' ft. to 32' ft., From ft. to ft.  
 GRAVEL PACK INTERVALS: From 18' ft. to 32' ft., From ft. to ft.

6 GROUT MATERIAL: 1 Neat cement 2 Cement grout 3 Bentonite 4 Other CLAY + BENTONITE  
 Grout Intervals: From ft. to ft., From ft. to ft., From ft. to 18' ft.  
 What is the nearest source of possible contamination:  
 1 Septic tank 4 Lateral lines 7 Pit privy 10 Livestock pens 14 Abandoned water well  
 2 Sewer lines 5 Cess pool 8 Sewage lagoon 11 Fuel storage 15 Oil well/Gas well  
 3 Watertight sewer lines 6 Seepage pit 9 Feedyard 12 Fertilizer storage 16 Other (specify below)  
 13 Insecticide storage none  
 Direction from well? How many feet?

FROM	TO	LITHOLOGIC LOG	FROM	TO	LITHOLOGIC LOG
1'	12'	SOIL			
13'	25'	SOFT SHALE			
26'	32'	HARD SHALE			

7 CONTRACTOR'S OR LANDOWNER'S CERTIFICATION: This water well was (1) constructed, (2) reconstructed, or (3) plugged under my jurisdiction and was completed on (mo/day/year) MAY 25, 1982 and this record is true to the best of my knowledge and belief. Kansas Water Well Contractor's License No. 249 This Water Well Record was completed on (mo/day/yr) June 29, 1982 under the business name of HUNT DRILLING Co by (signature) Walter A Hunt

INSTRUCTIONS: Use typewriter or ball point pen, PLEASE PRESS FIRMLY and PRINT clearly. Please fill in blanks, underline or circle the correct answers. Send top three copies to Kansas Department of Health and Environment, Division of Environment, Environmental Geology Section, Topeka, KS 66620. Send one to WATER WELL OWNER and retain one for your records.

OFFICE USE ONLY  
 T 34  
 R 3  
 S  
 EW  
 SEC. 11  
 NE 1/4  
 SE 1/4  
 NE 1/4