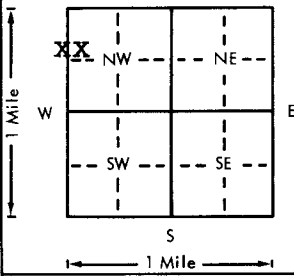
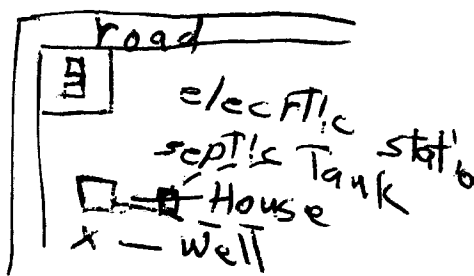


USE TYPEWRITER OR BALL
POINT PEN-PRESS FIRMLY,
PRINT CLEARLY.

WATER WELL RECORD
KSA 82a-1201-1215

Kansas Department of Health and
Environment-Division of Environment
(Water well Contractors)
Topeka, Kansas 66620

1. Location of well:		County Cowley	Fraction SW 1/4 NW 1/4 NW 1/4	Section number 11	Township number T 34 South S	Range number R 3 East E/W
2. Distance and direction from nearest town or city: 3 miles NW of Arkansas City, Kansas Street address of well location if in city:				3. Owner of well: Margie L. Berrie R.R. or street: R.R. 2 City, state, zip code: Arkansas City, Kansas 67005		
4. Locate with "X" in section below: N  W E S 1 Mile		Sketch map: 		6. Bore hole dia. 10 in. Completion date 7-1-80 Well depth 66 ft.		
5. Type and color of material		From	To	7. <input checked="" type="checkbox"/> Cable tool Rotary <input type="checkbox"/> Driven <input type="checkbox"/> Dug <input type="checkbox"/> Hollow rod <input type="checkbox"/> Jetted <input type="checkbox"/> Bored <input type="checkbox"/> Reverse rotary		
red clay		0	20	8. Use: <input checked="" type="checkbox"/> Domestic <input type="checkbox"/> Public supply <input type="checkbox"/> Industry <input type="checkbox"/> Irrigation <input type="checkbox"/> Air conditioning <input type="checkbox"/> Stock <input type="checkbox"/> Lawn <input type="checkbox"/> Oil field water <input type="checkbox"/> Other		
soft shale		21	55	9. Casing: Material rmp Height: Above or below Threading <input type="checkbox"/> Welded <input type="checkbox"/> Surface 16 in. RMP <input checked="" type="checkbox"/> PVC <input type="checkbox"/> Weight .55 lbs./ft. Dia. 6 in. to 66 ft. depth Wall thickness inches or Dia. <input type="checkbox"/> in. to <input type="checkbox"/> ft. depth gage No. #200		
cream colored lime		56	66	10. Screen: Manufacturer's name NA Type rmp Dia. 6" Slot/gauze 1/16 Length 10' Set between 56 ft. and 66 ft. Set between <input type="checkbox"/> ft. and <input type="checkbox"/> ft. Gravel pack? yes Size range of material 3/4"		
				11. Static water level: 35 ft. below land surface Date 7-1-80 ma./day/yr.		
				12. Pumping level below land surfaces: na ____ ft. after ____ hrs. pumping ____ g.p.m. ____ ft. after ____ hrs. pumping ____ g.p.m. Estimated maximum yield ____ g.p.m.		
				13. Water sample submitted: ____ mo./day/yr. Yes <input checked="" type="checkbox"/> No <input type="checkbox"/> Date		
				14. Well head completion: <input checked="" type="checkbox"/> Pitless adapter 16 inches above grade		
				15. Well grouted? yes With: <input checked="" type="checkbox"/> Neat cement <input type="checkbox"/> Bentonite <input type="checkbox"/> Concrete Depth: From 3 ft. to 13 ft.		
				16. Nearest source of possible contamination: septic ft. 50 Direction east Type tank Well disinfected upon completion? <input checked="" type="checkbox"/> Yes <input type="checkbox"/> No		
				17. Pump: Myers Not installed Manufacturer's name Model number s2h52 HP 1/2 Volts 220 Length of drop pipe 60 ft. capacity 11 g.p.m. Type: <input checked="" type="checkbox"/> Submersible <input type="checkbox"/> Turbine <input type="checkbox"/> Jet <input type="checkbox"/> Reciprocating <input type="checkbox"/> Centrifugal <input type="checkbox"/> Other		
18. Elevation:		(Use a second sheet if needed)		20. Water well contractor's certification: This well was drilled under my jurisdiction and this report is true to the best of my knowledge and belief. Eastman Drilling 299 Business name License No. 67156 Address Box 115, Winfield, KS Signed Del Estman Date 7-28-80 Authorized Representative		
19. Remarks:						

Forward the white, blue and pink copies to the Department of Health and Environment

Form WWC-5

34
3-0
W
11
67156
7/28/80
Sumner