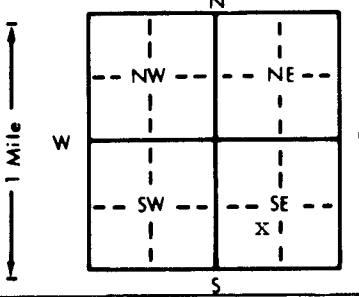


1 LOCATION OF WATER WELL: County: Cowley		Fraction NE 1/4 SW 1/4 SE 1/4		Section Number 26		Township Number T 34 S		Range Number R 3 E/W			
Distance and direction from nearest town or city street address of well if located within city? Approximately 1/4 mile west of Arkansas City											
2 WATER WELL OWNER: City of Arkansas City RR#, St. Address, Box # : P.O. Box 778 City, State, ZIP Code : Arkansas City, KS 67005		Board of Agriculture, Division of Water Resources Application Number: CL005 & 10084									
3 LOCATE WELL'S LOCATION WITH AN "X" IN SECTION BOX: 		4 DEPTH OF COMPLETED WELL: 38.6 ft. ELEVATION: Depth(s) Groundwater Encountered 1. ft. 2. ft. 3. ft. WELL'S STATIC WATER LEVEL 18.4 ft. below land surface measured on mo/day/yr 11-20-90 Pump test data: Well water was ft. after hours pumping gpm Est. Yield gpm: Well water was ft. after hours pumping gpm Bore Hole Diameter in. to ft., and in. to ft. WELL WATER TO BE USED AS: 5 Public water supply 8 Air conditioning 11 Injection well 1 Domestic 3 Feedlot 6 Oil field water supply 9 Dewatering 12 Other (Specify below) 2 Irrigation 4 Industrial 7 Lawn and garden only 10 Monitoring well Was a chemical/bacteriological sample submitted to Department? Yes.....No.....; If yes, mo/day/yr sample was submitted Water Well Disinfected? Yes ☒ No									
5 TYPE OF BLANK CASING USED: 1 Steel 3 RMP (SR) 5 Wrought iron 8 Concrete tile CASING JOINTS: Glued Clamped 2 PVC 4 ABS 6 Asbestos-Cement 9 Other (specify below) Welded 7 Fiberglass Cement Threaded Blank casing diameter 18 in. to ft., Dia in. to ft., Dia in. to ft. Casing height above land surface 38.6' below X, weight lbs./ft. Wall thickness or gauge No. TYPE OF SCREEN OR PERFORATION MATERIAL: 7 PVC 10 Asbestos-cement 1 Steel 3 Stainless steel 5 Fiberglass 8 RMP (SR) 11 Other (specify) 2 Brass 4 Galvanized steel 6 Concrete tile 9 ABS 12 None used (open hole) SCREEN OR PERFORATION OPENINGS ARE: 5 Gauzed wrapped 8 Saw cut 11 None (open hole) 1 Continuous slot 3 Mill slot 6 Wire wrapped 9 Drilled holes 2 Louvered shutter 4 Key punched 7 Torch cut 10 Other (specify) SCREEN-PERFORATED INTERVALS: From ft. to ft., From ft. to ft. From ft. to ft., From ft. to ft. GRAVEL PACK INTERVALS: From ft. to ft., From ft. to ft. From ft. to ft., From ft. to ft.											
6 GROUT MATERIAL: 1 Neat cement 2 Cement grout 3 Bentonite 4 Other Grout Intervals: From 5 ft. to 20 ft., From ft. to ft., From ft. to ft. What is the nearest source of possible contamination: 1 Septic tank 4 Lateral lines 7 Pit privy 10 Livestock pens 14 Abandoned water well 2 Sewer lines 5 Cess pool 8 Sewage lagoon 11 Fuel storage 15 Oil well/Gas well 3 Watertight sewer lines 6 Seepage pit 9 Feedyard 12 Fertilizer storage 16 Other (specify below) 13 Insecticide storage None known Direction from well? How many feet?											
FROM		TO		LITHOLOGIC LOG		FROM		TO		PLUGGING INTERVALS	
						38.6		20		Chlorinated cement sand	
						20		5		Neat Cement	
						5		0		Open (future cut off)	
NOTE: THE WELL IS IN A PUMP HOUSE ELEVATED ABOVE NORMAL GROUND LEVEL. THE OWNER PLANS TO REMOVE BUILDING & CUT OFF PIPE 5' BELOW TOP OF EXISTING CASING DWC											
7 CONTRACTOR'S OR LANDOWNER'S CERTIFICATION: This water well was (1) constructed, (2) reconstructed, or (3) plugged under my jurisdiction and was completed on (mo/day/year) 11-20-90 and this record is true to the best of my knowledge and belief. Kansas Water Well Contractor's License No. 185 This Water Well Record was completed on (mo/day/yr) 11-29-91 under the business name of Clarke Well & Equipment, Inc. by (signature) <i>Clarke</i>											