


1 LOCATION OF WATER WELL: Fraction SE 1/4 NW 1/4 INW 1/4 Section Number 35 Township Number T 34 S Range Number R 3 E/W

Distance and direction from nearest town or city street address of well if located within city? 1/2 MILE W of ARKANSAS RIVER BRIDGE on US 166 + 1/4 MILES SOUTH of ARK CITY

2 WATER WELL OWNER: SUMNER COUNTY RWD No 4 RR#, St. Address, Box #: R# 1 GEUDA SPRINGS, KANSAS 67051 Board of Agriculture, Division of Water Resources Application Number:

3 LOCATE WELL'S LOCATION WITH AN "X" IN SECTION BOX:

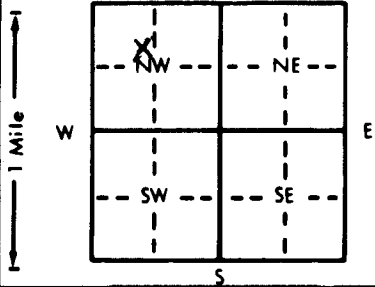

4 DEPTH OF COMPLETED WELL: ft. ELEVATION:

Depth(s) Groundwater Encountered 1. ft. 2. ft. 3. ft. WELL'S STATIC WATER LEVEL 8' ft. below land surface measured on mo/day/yr 6-9-1988 Pump test data: Well water was ... ft. after ... hours pumping ... gpm Est. Yield ... gpm: Well water was ... ft. after ... hours pumping ... gpm Bore Hole Diameter ... in. to ... ft., and ... in. to ... ft. WELL WATER TO BE USED AS: 5 Public water supply 8 Air conditioning 11 Injection well 1 Domestic 3 Feedlot 6 Oil field water supply 9 Dewatering 12 Other (Specify below) 2 Irrigation 4 Industrial 7 Lawn and garden only 10 Observation well Was a chemical/bacteriological sample submitted to Department? Yes... No...; If yes, mo/day/yr sample was submitted Water Well Disinfected? Yes No

5 TYPE OF BLANK CASING USED: 1 Steel 3 RMP (SR) 5 Wrought iron 8 Concrete tile CASING JOINTS: Glued Clamped Welded Threaded

Blank casing diameter 1.2 in. to 1.8 ft. Dia 2.4 in. to 1.0 ft. Dia Casing height above land surface 12 in., weight lbs./ft. Wall thickness or gauge No. 10

TYPE OF SCREEN OR PERFORATION MATERIAL: 2 Brass 4 Galvanized steel 5 Fiberglass 8 RMP (SR) 10 Asbestos-cement 11 Other (specify) 12 None used (open hole)

SCREEN OR PERFORATION OPENINGS ARE: 1 Continuous slot 3 Mill slot 5 Gauzed wrapped 8 Saw cut 11 None (open hole) 2 Louvered shutter 4 Key punched 6 Wire wrapped 9 Drilled holes 10 Other (specify)

SCREEN-PERFORATED INTERVALS: From ... ft. to ... ft. GRAVEL PACK INTERVALS: From ... ft. to ... ft.

6 GROUT MATERIAL: 1 Neat cement 2 Cement grout 3 Bentonite 4 Other Grout intervals: From ... ft. to ... ft.

What is the nearest source of possible contamination: 1 Septic tank 4 Lateral lines 7 Pit privy 10 Livestock pens 14 Abandoned water well 2 Sewer lines 5 Cess pool 8 Sewage lagoon 11 Fuel storage 15 Oil well/Gas well 3 Watertight sewer lines 6 Seepage pit 9 Feedyard 12 Fertilizer storage 16 Other (specify below) 13 Insecticide storage Direction from well? none How many feet?

FROM	TO	LITHOLOGIC LOG	FROM	TO	LITHOLOGIC LOG
28'	14'	Sand (Chlorinated)			
16'	8'	Clay "			
8'	3'	Cement Grout			
3'	to	ground level - Surface Soil			

7 CONTRACTOR'S OR LANDOWNER'S CERTIFICATION: This water well was (1) constructed, (2) reconstructed, or (3) plugged under my jurisdiction and was completed on (mo/day/year) 6-9-1988 and this record is true to the best of my knowledge and belief. Kansas Water Well Contractor's License No. 249 This Water Well Record was completed on (mo/day/yr) 6-9-1988 under the business name of HUNT DRILLING Co by signature Walter Hunt