WATER WELL RECORD Form WWC-5 KSA 82a-1212

1 LOCATION OF WATER WELL: County: COWLEY | Fraction: NW ¼ NW ¼ NW ¼ | Section Number: 36 | Township Number: T 34 S | Range Number: R 3 (E/W)

Distance and direction from nearest town or city street address of well if located within city?

2 WATER WELL OWNER: ASIEPA

RR#, St. Address, Box # :

City, State, ZIP Code : DALLAS TX

Board of Agriculture, Division of Water Resourc

Application Number:

3 LOCATE WELL'S LOCATION WITH AN "X" IN SECTION BOX:

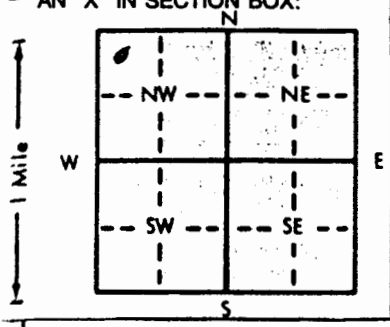

4 DEPTH OF COMPLETED WELL 18.5 ft. ELEVATION:

Depth(s) Groundwater Encountered 1. ft. 2. ft. 3. ft.

WELL'S STATIC WATER LEVEL 999 ft. below land surface measured on mo/day/yr

Pump test data: Well water was ft. after hours pumping gpr

Est. Yield gpm: Well water was ft. after hours pumping gpr

Bore Hole Diameter 8 in. to 18.5 ft., and in. to ft

WELL WATER TO BE USED AS: 1 Domestic 2 Irrigation 3 Feedlot 4 Industrial 5 Public water supply 6 Oil field water supply 7 Lawn and garden only 8 Air conditioning 9 Dewatering (10) Observation well 11 Injection well 12 Other (Specify below) MONITOR WELL

Was a chemical/bacteriological sample submitted to Department? Yes No ; If yes, mo/day/yr sample was submitted

Water Well Disinfected? Yes No X

5 TYPE OF BLANK CASING USED: 1 Steel (2) PVC 3 RMP (SR) 4 ABS 5 Wrought iron 6 Asbestos-Cement 7 Fiberglass 8 Concrete tile 9 Other (specify below)

CASING JOINTS: Glued Clamped Welded Threaded X

Blank casing diameter 2 in. to ft., Dia in. to ft., Dia in. to ft

Casing height above land surface 24 in., weight lbs./ft. Wall thickness or gauge No. SCH. 40

TYPE OF SCREEN OR PERFORATION MATERIAL: 1 Steel 2 Brass 3 Stainless steel 4 Galvanized steel 5 Fiberglass 6 Concrete tile (7) PVC 8 RMP (SR) 9 ABS 10 Asbestos-cement 11 Other (specify) 12 None used (open hole)

SCREEN OR PERFORATION OPENINGS ARE: 1 Continuous slot 2 Louvered shutter (3) Mill slot 4 Key punched 5 Gauzed wrapped 6 Wire wrapped 7 Torch cut 8 Saw cut 9 Drilled holes 10 Other (specify) 11 None (open hole)

SCREEN-PERFORATED INTERVALS: From 13.5 ft. to 18.5 ft., From ft. to ft

From ft. to ft., From ft. to ft

GRAVEL PACK INTERVALS: From 11.5 ft. to 18.5 ft., From ft. to ft

From ft. to ft., From ft. to ft

6 GROUT MATERIAL: 1 Neat cement (2) Cement grout 3 Bentonite 4 Other

Grout Intervals: From 9.5 ft. to 0.0 ft., From ft. to ft., From ft. to ft

What is the nearest source of possible contamination:

1 Septic tank 2 Sewer lines 3 Watertight sewer lines 4 Lateral lines 5 Cess pool 6 Seepage pit 7 Pit privy 8 Sewage lagoon 9 Feedyard 10 Livestock pens 11 Fuel storage 12 Fertilizer storage 13 Insecticide storage 14 Abandoned water well 15 Oil well/Gas well 16 Other (specify below) NOT KNOWN

Direction from well? How many feet?

FROM	TO	LITHOLOGIC LOG	FROM	TO	LITHOLOGIC LOG
0.0	3.5	SILTY SANDY CLAY			
3.5	8.5	SAND, FINE			
8.5	18.5	SAND, COARSE to MED			

RECEIVED OCT 19 1992 DIVISION OF ENVIRONMENT

7 CONTRACTOR'S OR LANDOWNER'S CERTIFICATION: This water well was (1) constructed, (2) reconstructed, or (3) plugged under my jurisdiction and was completed on (mo/day/year) 2-26-92 and this record is true to the best of my knowledge and belief. Kansas Water Well Contractor's License No. 458 This Water Well Record was completed on (mo/day/yr) 3-11-92 under the business name of THE WINNER CO INC by (signature) Dale Jim Bowlin

INSTRUCTIONS: Use typewriter or ball point pen. *PLEASE PRESS FIRMLY* and *PRINT* clearly. Please fill in blanks, underline or circle the correct answers. Send top three copies to Kansas Department of Health and Environment, Office of Oil Field and Environmental Geology, Regulation and Permitting Section, Topeka, Kansas 66620-7500, Telephone: 913-862-9360. Send one to WATER WELL OWNER and retain one for your records.