


1 LOCATION OF WATER WELL:	Fraction	Section Number	Township Number	Range Number
County: Cowley	NW ¼ NW ¼ SE ¼	36	T 34 S	R 3 EW

Distance and direction from nearest town or city street address of well if located within city? Well No. 2 West
SW corner of 6th & Taylor in Arkansas City

2 WATER WELL OWNER:	City of Arkansas City		
	118 W. Central		
RR #, St. Address, Box #:	Arkansas City Ks		
City, State, ZIP Code :	Board of Agriculture, Division of Water Resources		
	Application Number:		

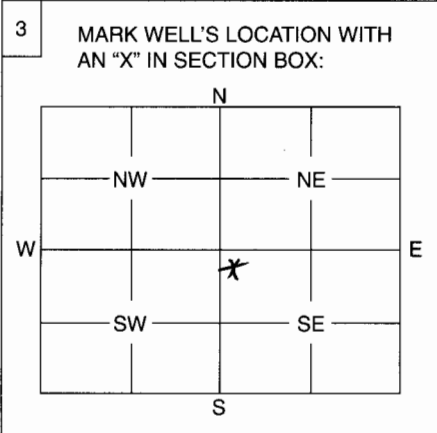

4 DEPTH OF WELL	40.92	ft.
WELL'S STATIC WATER LEVEL	15.9	ft.
WELL WAS USED AS:		
1 Domestic	5 Public Water Supply	9 Dewatering
2 Irrigation	6 Oil Field Water Supply	10 Monitoring Well
3 Feedlot	7 Domestic (Lawn & Garden)	11 Injection Well
4 Industrial	8 Air Conditioning	12 Other unknown
Was a chemical / bacteriological sample submitted to Department? Yes No <input checked="" type="checkbox"/>		
If yes, mo/day/yr sample was submitted		
Water Well Disinfected: Yes <input checked="" type="checkbox"/> No		

5 TYPE OF BLANK CASING USED:	1 Steel 3 RMP (SR) 5 Wrought 7 Fiberglass 9 Other (Specify below)		
	2 PVC 4 ABS 6 Asbestos-Cement 8 Concrete Tile		
Blank casing diameter 19-1/4 in.	Was casing pulled?	Yes	No <input checked="" type="checkbox"/> If yes, how much
Casing height above or below land surface 62	in.		

6 GROUT PLUG MATERIAL:	1 Neat cement	2 Cement grout	3 Bentonite	4 Other chlorinated sand
Grout Plug Intervals:	<input type="radio"/> From 3 ft. to 14.20 ft.	<input checked="" type="radio"/> From 14.20 ft. to 16 ft.	<input checked="" type="radio"/> From 16 ft. to 40.92 ft.	
What is the nearest source of possible contamination:				
1 Septic tank	6 Seepage pit	11 Fuel storage	16 Other (specify below)	
2 Sewer lines	7 Pit privy	12 Fertilizer storage	
3 Watertight sewer lines	8 Sewage lagoon	13 Insecticide storage	unknown	
4 Lateral lines	9 Feedyard	14 Abandoned water well		
5 Cess pool	10 Livestock pens	15 Oil well/Gas well		
Direction from well?				
How many feet?				

FROM	TO	PLUGGING MATERIALS
40'11	16	chlorinated gravel
16'	14.20	hole plug
14.20	3	cement

7 CONTRACTOR'S OF LANDOWNER'S CERTIFICATION:	This water well was plugged under my jurisdiction and was completed on (mo/day/year) 1/23/2007		
	and this record is true to the best of my knowledge and belief. Kansas Water Well Contractor's License No. 102		
	This Water Well Record was completed on (mo/day/year) 1/26/2007		
	under the business name of Layne Christensen Co.		
	by (signature) <i>[Signature]</i>		

INSTRUCTIONS: Use typewriter or ball point pen. Please press firmly and print clearly. Please fill in blanks, underline or circle the correct answers. Send top three copies to Kansas Department of Health and Environment, Bureau of Water, Geology Section, 1000 SW Jackson St., Ste. 420, Topeka, Kansas 66612-1367. Telephone: 785/296-5522. Send one to Water Well Owner and retain one for your records.