


1 LOCATION OF WATER WELL: Fraction SE 1/4 NE 1/4 NE 1/4 Section Number 24 Township Number T 34 S Range Number R 3 E/W
 County: Cowley

Distance and direction from nearest town or city street address of well if located within city?
1705 N. Summit; 1/2 S, 1' E of SW corner of Sam's building

2 WATER WELL OWNER: Coastal Mart, Inc.
 RR#, St. Address, Box #: 110 S. Main, Suite 500 Board of Agriculture, Division of Water Resources
 City, State, ZIP Code: Wichita, KS 67202 Application Number:

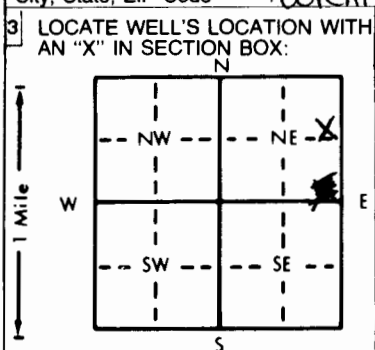

4 DEPTH OF COMPLETED WELL: 16.0 ft. ELEVATION: 1088.30 TOC
 Depth(s) Groundwater Encountered 1. ft. 2. ft. 3. ft.
 WELL'S STATIC WATER LEVEL 10.28 ft. below land surface measured on mo/day/yr 2-12-98
 Pump test data: Well water was ft. after hours pumping gpm
 Est. Yield gpm: Well water was ft. after hours pumping gpm
 Bore Hole Diameter: 8 in. to 16 ft., and in. to ft.
 WELL WATER TO BE USED AS:
 5 Public water supply 8 Air conditioning 11 Injection well
 1 Domestic 3 Feedlot 6 Oil field water supply 9 Dewatering 12 Other (Specify below)
 2 Irrigation 4 Industrial 7 Lawn and garden only 10 Monitoring well
 Was a chemical/bacteriological sample submitted to Department? Yes No X ; If yes, mo/day/yr sample was submitted
 Water Well Disinfected? Yes No X

5 TYPE OF BLANK CASING USED:
 1 Steel 3 RMP (SR) 5 Wrought iron 8 Concrete tile CASING JOINTS: Glued Clamped
2 PVC 4 ABS 7 Fiberglass Threaded flush
 Blank casing diameter 2 in. to 6 ft., Dia in. to ft., Dia in. to ft.
 Casing height above land surface: flush in., weight 0.703 lbs./ft. Wall thickness or gauge No. sch 40
 TYPE OF SCREEN OR PERFORATION MATERIAL:
 1 Steel 3 Stainless steel 5 Fiberglass 7 PVC 10 Asbestos-cement
 2 Brass 4 Galvanized steel 6 Concrete tile 8 RMP (SR) 11 Other (specify)
 12 None used (open hole)
 SCREEN OR PERFORATION OPENINGS ARE:
 1 Continuous slot 3 Mill slot 5 Gauzed wrapped 8 Saw cut 11 None (open hole)
 2 Louvered shutter 4 Key punched 6 Wire wrapped 9 Drilled holes
 7 Torch cut 10 Other (specify)
 SCREEN-PERFORATED INTERVALS: From 6 ft. to 16 ft., From ft. to ft.
 From ft. to ft., From ft. to ft.
 GRAVEL PACK INTERVALS: From 4 ft. to 16 ft., From ft. to ft.
 From ft. to ft., From ft. to ft.

6 GROUT MATERIAL: 1 Neat cement 2 Cement grout 3 Bentonite 4 Other
 Grout Intervals: From 1 ft. to 4 ft., From ft. to ft., From ft. to ft.

What is the nearest source of possible contamination:
 1 Septic tank 4 Lateral lines 7 Pit privy 10 Livestock pens 14 Abandoned water well
 2 Sewer lines 5 Cess pool 8 Sewage lagoon 11 Fuel storage 15 Oil well/Gas well
 3 Watertight sewer lines 6 Seepage pit 9 Feedyard 12 Fertilizer storage 16 Other (specify below)
 13 Insecticide storage
 Direction from well? How many feet?

FROM	TO	LITHOLOGIC LOG	FROM	TO	PLUGGING INTERVALS
0	1.5	Topsoil/Fill			
1.5	13	Clay, m-h plasticity			
13	14	Sand, f-vc grained			
14	16	Clay, some sand			

7 CONTRACTOR'S OR LANDOWNER'S CERTIFICATION: This water well was (1 constructed) (2) reconstructed, or (3) plugged under my jurisdiction and was completed on (mo/day/year) 3/4/98 and this record is true to the best of my knowledge and belief. Kansas Water Well Contractor's License No. 531 This Water Well Record was completed on (mo/day/yr) 3/25/98 under the business name of GSI by (signature) Candace Watson

OFFICE USE ONLY
T
R
EW
SEC.
1/4
1/4
1/4