

**WATER WELL RECORD Form WWC-5**


Original Record  Correction  Change in Well Use

Division of Water Resources App. No.

Well ID MW6

|   |                                 |                             |                                  |                                |
|---|---------------------------------|-----------------------------|----------------------------------|--------------------------------|
| <b>1 LOCATION OF WATER WELL:</b><br>County: <b>COWLEY</b> | Fraction<br>NE ¼ NE ¼ NE ¼ NE ¼ | Section Number<br><b>13</b> | Township Number<br><b>T 34 S</b> | Range Number<br><b>R 3 E W</b> |
|---|---------------------------------|-----------------------------|----------------------------------|--------------------------------|

|   |  |
|---|--|
| <b>2 WELL OWNER:</b> Last Name: _____ First: _____<br>Business: <b>CASEY'S GENERAL STORE #3435</b><br>Address: <b>3413 N. SUMMIT</b><br>Address: _____<br>City: <b>ARKANSAS CITY</b> State: <b>KS</b> ZIP: <b>67005</b> | Street or Rural Address where well is located (if unknown, distance and direction from nearest town or intersection): If at owner's address, check here: <input checked="" type="checkbox"/> |
|---|--|
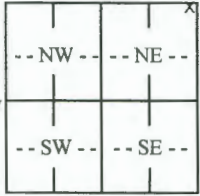
|   |   |   |
|---|---|---|
| <b>3 LOCATE WELL WITH "X" IN SECTION BOX:</b><br>N<br><br>W<br>E<br>S<br>----- 1 mile ----- | <b>4 DEPTH OF COMPLETED WELL:</b> ..... <b>15.6</b> ..... ft.<br>Depth(s) Groundwater Encountered: 1) ..... ft.<br>2) ..... ft. 3) ..... ft., or 4) <input type="checkbox"/> Dry Well<br>WELL'S STATIC WATER LEVEL: ..... <b>12.61</b> ..... ft.<br><input checked="" type="checkbox"/> below land surface, measured on (mo-day-yr)..... <b>9/6/18</b> .....<br><input type="checkbox"/> above land surface, measured on (mo-day-yr).....<br>Pump test data: Well water was ..... ft.<br>after ..... hours pumping ..... gpm<br>Well water was ..... ft.<br>after ..... hours pumping ..... gpm<br>Estimated Yield: ..... gpm<br>Bore Hole Diameter: ..... in. to ..... ft. and<br>..... in. to ..... ft. | <b>5 Latitude:</b> ..... <b>37.09939</b> ..... (decimal degrees)<br><b>Longitude:</b> ..... <b>97.04080</b> ..... (decimal degrees)<br>Horizontal Datum: <input checked="" type="checkbox"/> WGS 84 <input type="checkbox"/> NAD 83 <input type="checkbox"/> NAD 27<br>Source for Latitude/Longitude:<br><input type="checkbox"/> GPS (unit make/model: .....)<br>(WAAS enabled? <input type="checkbox"/> Yes <input type="checkbox"/> No)<br><input checked="" type="checkbox"/> Land Survey <input type="checkbox"/> Topographic Map<br><input type="checkbox"/> Online Mapper: ..... |
|   |   | <b>6 Elevation:</b> <b>1173.24</b> .....ft. <input type="checkbox"/> Ground Level <input checked="" type="checkbox"/> TOC<br>Source: <input checked="" type="checkbox"/> Land Survey <input type="checkbox"/> GPS <input type="checkbox"/> Topographic Map<br><input type="checkbox"/> Other .....  |

**7 WELL WATER TO BE USED AS:**

|  |  |   |
|--|--|---|
| 1. Domestic:<br><input type="checkbox"/> Household<br><input type="checkbox"/> Lawn & Garden<br><input type="checkbox"/> Livestock | 5. <input type="checkbox"/> Public Water Supply: well ID .....                     | 10. <input type="checkbox"/> Oil Field Water Supply: lease .....                                      |
| 2. <input type="checkbox"/> Irrigation   | 6. <input type="checkbox"/> Dewatering: how many wells? .....                      | 11. Test Hole: well ID .....  |
| 3. <input type="checkbox"/> Feedlot  | 7. <input type="checkbox"/> Aquifer Recharge: well ID .....                        | <input type="checkbox"/> Cased <input type="checkbox"/> Uncased <input type="checkbox"/> Geotechnical |
| 4. <input type="checkbox"/> Industrial   | 8. <input checked="" type="checkbox"/> Monitoring: well ID ..... <b>MW6</b> .....  | 12. Geothermal: how many bores? .....   |
|  | 9. Environmental Remediation: well ID .....  | a) Closed Loop <input type="checkbox"/> Horizontal <input type="checkbox"/> Vertical                  |
|  | <input type="checkbox"/> Air Sparge <input type="checkbox"/> Soil Vapor Extraction | b) Open Loop <input type="checkbox"/> Surface Discharge <input type="checkbox"/> Inj. of Water        |
|  | <input type="checkbox"/> Recovery <input type="checkbox"/> Injection               | 13. <input type="checkbox"/> Other (specify): .....   |

**Was a chemical/bacteriological sample submitted to KDHE?**  Yes  No If yes, date sample was submitted: .....

Water well disinfected?  Yes  No

**8 TYPE OF CASING USED:**  Steel  PVC  Other ..... CASING JOINTS:  Glued  Clamped  Welded  Threaded  
Casing diameter ..... **2** ..... in. to ..... **15.6** ..... ft., Diameter ..... in. to ..... ft., Diameter ..... in. to ..... ft.  
Casing height above land surface ..... in. Weight ..... lbs./ft. Wall thickness or gauge No. ....

**TYPE OF SCREEN OR PERFORATION MATERIAL:**  
 Steel  Stainless Steel  Fiberglass  PVC  Other (Specify) .....

Brass  Galvanized Steel  Concrete tile  None used (open hole)

**SCREEN OR PERFORATION OPENINGS ARE:**  
 Continuous Slot  Mill Slot  Gauze Wrapped  Torch Cut  Drilled Holes  Other (Specify) .....

Louvered Shutter  Key Punched  Wire Wrapped  Saw Cut  None (Open Hole)

**SCREEN-PERFORATED INTERVALS:** From **5.6** ..... ft. to **15.6** ..... ft., From ..... ft. to ..... ft., From ..... ft. to ..... ft.

**GRAVEL PACK INTERVALS:** From **3.6** ..... ft. to **15.6** ..... ft., From ..... ft. to ..... ft., From ..... ft. to ..... ft.

**9 GROUT MATERIAL:**  Neat cement  Cement grout  Bentonite  Other **Concrete Surface Completion 0-1** .....


Grout Intervals: From **1** ..... ft. to **3.6** ..... ft., From ..... ft. to ..... ft., From ..... ft. to ..... ft.

**Nearest source of possible contamination:**  
 Septic Tank  Lateral Lines  Pit Privy  Livestock Pens  Insecticide Storage  
 Sewer Lines  Cess Pool  Sewage Lagoon  Fuel Storage  Abandoned Water Well  
 Watertight Sewer Lines  Seepage Pit  Feedyard  Fertilizer Storage  Oil Well/Gas Well  
 Other (Specify) .....

Direction from well? ..... Distance from well? ..... ft.

| 10 FROM | TO | LITHOLOGIC LOG | FROM | TO | LITHO. LOG (cont.) or PLUGGING INTERVALS |
|---------|----|----------------|------|----|--|
| 0       | 15 | SILTY CLAY     |      |    |  |
|         |    |                |      |    |  |
|         |    |                |      |    |  |
**11 CONTRACTOR'S OR LANDOWNER'S CERTIFICATION:** This water well was  constructed,  reconstructed, or  plugged under my jurisdiction and was completed on (mo-day-year) **2/20/18** ..... and this record is true to the best of my knowledge and belief. Kansas Water Well Contractor's License No. **585** ..... This Water Well Record was completed on (mo-day-year) **2/26/18** ..... under the business name of **ASSOCIATED ENVIRONMENTAL INC.** Signature *[Signature]*

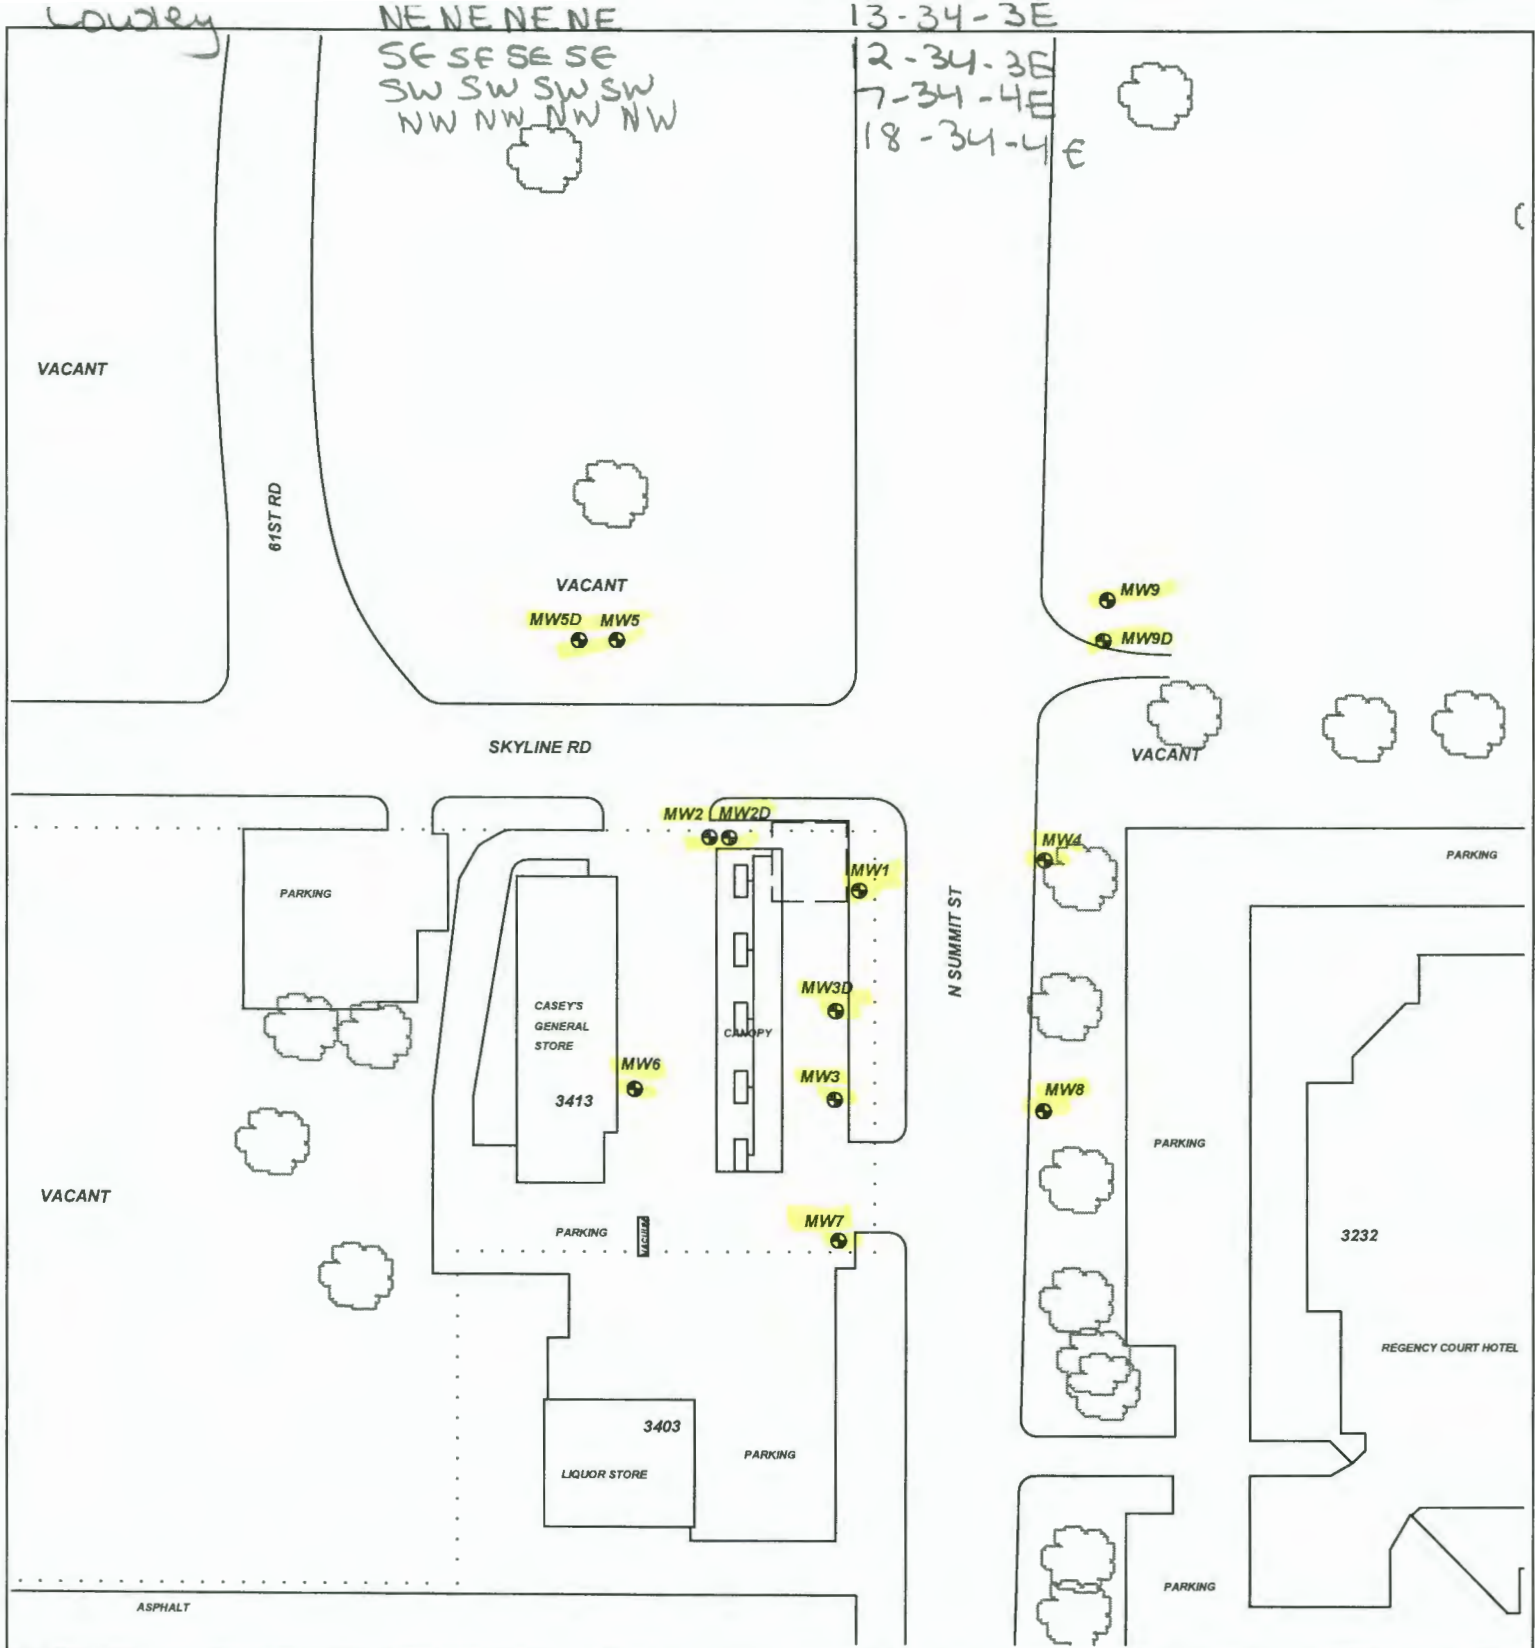

**PROJECT:** CASEY'S GENERAL STORE #3435

**ADDRESS:** 3413 N. SUMMIT

**LOCATION:** ARKANSAS CITY, KS

**DRAWN BY:** B. STALNAKER **DATE:** 4/26/17

**REVISED BY:** B. STALNAKER **DATE:** 9/27/18





**AEI JOB #:** TF501 **KDHE JOB #:** U2-018-14122


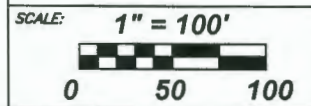
**TITLE:**



**ASSOCIATED ENVIRONMENTAL INC.**

**LEGEND:**

-  = CURRENT UST's (1)8,000 & (1)12,000 GAL GASOLINE, (1)10,000 GAL. DIESEL
-  = MONITOR WELL
-  = CURRENT PUMPS AND PRODUCT LINES
-  = SUBJECT PROPERTY

**NOTES:**  
No basements observed within 500'.