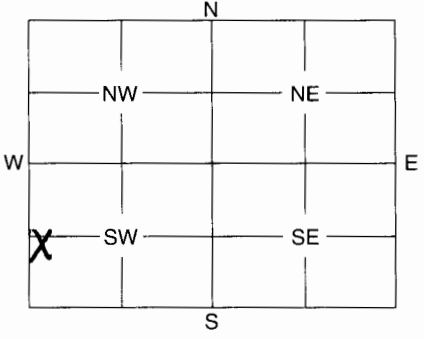


1	LOCATION OF WATER WELL:	Fraction	Section	Number	Township	Number	Range	Number
	County: <u>Cowley</u>	<u>NW 1/4 SW 1/4 SW 1/4</u>	<u>19</u>		<u>T 34 S</u>		<u>R 4</u>	<u>E 2W</u>

Distance and direction from nearest town or city street address of well if located within city?

1015 N. Summit, Arkansas City, Kansas

2	WATER WELL OWNER: <u>E Z Mart Inc</u>	Board of Agriculture, Division of Water Resources
	RR #, St. Address, Box #: <u>PO Box 1426</u>	Application Number:
	City, State, ZIP Code: <u>Texarkana, TX 75504</u>	

3	MARK WELL'S LOCATION WITH AN "X" IN SECTION BOX:	4	DEPTH OF WELL <u>17.5</u> ft.
	WELL'S STATIC WATER LEVEL _____ ft.		
	WELL WAS USED AS:		
	<div style="display: flex; justify-content: space-between;"> <div> 1 Domestic 2 Irrigation 3 Feedlot 4 Industrial </div> <div> 5 Public Water Supply 6 Oil Field Water Supply 7 Domestic (Lawn & Garden) 8 Air Conditioning </div> <div> 9 Dewatering 10 <u>Monitoring Well</u> 11 Injection Well 12 Other _____ </div> </div>		
			
	Was a chemical / bacteriological sample submitted to Department? Yes _____ No <u>X</u>		
	If yes, mo/day/yr sample was submitted _____		
	Water Well Disinfected: Yes _____ No <u>X</u>		

5	TYPE OF BLANK CASING USED:
	1 Steel 3 RMP (SR) 5 Wrought 7 Fiberglass 9 Other (Specify below) <u>2 PVC</u> 4 ABS 6 Asbestos-Cement 8 Concrete Tile
	Blank casing diameter <u>2</u> in. Was casing pulled? Yes <u>X</u> No _____ If yes, how much <u>17.5'</u>
	Casing height above or below land surface _____ in.

6	GROUT PLUG MATERIAL:	1 Neat cement	2 Cement grout	<u>3 Bentonite</u>	4 Other _____
	GROUT PLUG INTERVALS:	From <u>17.5</u> ft.	to <u>3</u> ft.	From _____ ft.	to _____ ft.
	What is the nearest source of possible contamination:				
	1 Septic tank 6 Seepage pit <u>11 Fuel storage</u> 16 Other (specify below) 2 Sewer lines 7 Pit privy 12 Fertilizer storage 3 Watertight sewer lines 8 Sewage lagoon 13 Insecticide storage 4 Lateral lines 9 Feedyard 14 Abandoned water well 5 Cess pool 10 Livestock pens 15 Oil well/Gas well				
	Direction from well? <u>In Basin</u>	How many feet? <u>0</u>			

FROM	TO	PLUGGING MATERIALS
<u>0</u>	<u>3</u>	<u>Native Soil / Concrete Surface</u>
<u>3</u>	<u>17.5</u>	<u>Bentonite Slurry Grout</u>

MW-1
RECEIVED
OCT 20 2004
BUREAU OF WATER

7	CONTRACTOR'S OR LANDOWNER'S CERTIFICATION: This water well was plugged under my jurisdiction and was completed on (mo/day/year) <u>9/28/04</u> and this record is true to the best of my knowledge and belief. Kansas Water Well Contractor's License No. <u>904</u> This Water Well Record was completed on (mo/day/year) <u>10/12/04</u> under the business name of _____ by (signature) <u>David Hanzke</u>
---	--

INSTRUCTIONS: Use typewriter or ball point pen. Please press firmly and print clearly. Please fill in blanks, underline or circle the correct answers. Send top three copies to Kansas Department of Health and Environment, Bureau of Water, Geology Section, 1000 SW Jackson St., Ste. 420, Topeka, Kansas 66612-1367. Telephone: 785/296-5522. Send one to Water Well Owner and retain one for your records.