


1 LOCATION OF WATER WELL: County: Cowley		Fraction SW ¼ NW ¼ NW ¼	Section Number 30	Township Number T 34 S	Range Number R 4 E
--	--	-----------------------------------	-----------------------------	----------------------------------	------------------------------

Distance and direction from nearest town or city street address of well if located within city?
615 N. Summit, Arkansas City

2 WATER WELL OWNER: Mason Oil Co.		
RR#, St. Address, Box #	: P.O. Box 648	Board of Agriculture, Division of Water Resources
City, State, ZIP Code	: Arkansas City, Kansas 67005	Application Number:

3] LOCATE WELL'S LOCATION
WITH AN "X" IN SECTION BOX:

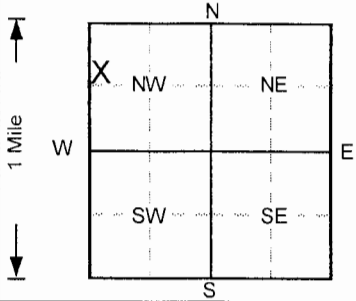

4 DEPTH OF COMPLETED WELL 21.5 ft. ELEVATION: 1086.95
 Depth(s) Groundwater Encountered 1. ft. 2. ft. 3. ft.
 WELL'S STATIC WATER LEVEL ft. below land surface measured on mo/day/yr
 Pump test data: Well water was NA ft. after hours pumping gpm
 Est. Yield .. NA .. gpm: Well water was ft. after hours pumping gpm
 Bore Hole Diameter 8 in. to 21.5 ft., and in. to ft.
 WELL WATER TO BE USED AS: 5 Public water supply 8 Air conditioning 11 Injection well
 1 Domestic 3 Feedlot 6 Oil field water supply 9 Dewatering 12 Other (Specify below)
 2 Irrigation 4 Industrial 7 Lawn and garden only 10 Monitoring well
 Was a chemical/bacteriological sample submitted to Department? Yes.....No✓ ; If yes, mo/day/yr sample was submitted
 Water Well Disinfected? Yes No ✓

5 TYPE OF BLANK CASING USED:

1 Steel	3 RMP (SR)	5 Wrought iron	8 Concrete tile	CASING JOINTS: Glued Clamped
2 PVC	4 ABS	6 Asbestos-Cement	9 Other (specify below)	Welded
		7 Fiberglass		Threaded. <input checked="" type="checkbox"/>

Blank casing diameter 2 in. to 11 ft. Dia in. to ft. Dia in. to ft. Dia

Casing height above land surface -6.24 in. weight lbs./ft. Wall thickness or gauge No. Sch. 40

TYPE OF SCREEN OR PERFORATION MATERIAL

1 Steel	3 Stainless steel	5 Fiberglass	7 PVC	10 Asbestos-cement
2 Brass	4 Galvanized steel	6 Concrete tile	8 RMP (SR)	11 Other (specify)
			9 ABS	12 None used (open hole)

SCREEN OR PERFORATION OPENINGS ARE:

1 Continuous slot	3 Mill slot	5 Gauzed wrapped	8 Saw cut	11 None (open hole)
2 Louvered shutter	4 Key punched	6 Wire wrapped	9 Drilled holes	
		7 Torch cut	10 Other (specify)	

SCREEN-PERFORATED INTERVALS: From 11 ft. to 21 ft. From ft. to ft. From ft. to ft.

GRAVEL PACK INTERVALS: From 9 ft. to 21 ft. From ft. to ft. From ft. to ft.

6 GROUT MATERIAL:		1 Neat cement	2 Cement grout	3 Bentonite	4 Other Concrete
Grout Intervals: From		0	ft. to	1	ft. to
		1	ft. to	9	ft. to
What is the nearest source of possible contamination:					
1 Septic tank	4 Lateral lines	7 Pit privy	10 Livestock pens	14 Abandoned water well	
2 Sewer lines	5 Cess pool	8 Sewage lagoon	11 Fuel storage	15 Oil well/Gas well	
3 Watertight sewer lines	6 Seepage pit	9 Feedyard	12 Fertilizer storage	16 Other (specify below)	
Direction from well?			13 Insecticide storage		
			How many feet?		

FROM	TO	LITHOLOGIC LOG	FROM	TO	PLUGGING INTERVALS
0	3	Silt, sl. sandy, moist, no odor,			
3	6	Clay, silty, moist, plastic, no odor, Grayish Br			
6	10	Clay, silty, moist, plastic, no odor, Brown			
10	17	Clay, v. silty, moist, plastic, no odor, Reddish			
17	19	Shale, v. firm, no odor, Gray with Tan Limest			
19	21.5	Limestone, hard to v. hard, dry, Gray			
					MW11 , Tag # 00370228 , Flushmount
					Project Name: Mason Oil Co. - TM
					GeoCore # 1263 , KDHE # U2 018 12046

7 CONTRACTOR'S OR LANDOWNER'S CERTIFICATION: This water well was (1) constructed, (2) reconstructed, or (3) plugged under my jurisdiction and was completed on (mo/day/year) 2/15/2006 and this record is true to the best of my knowledge and belief. Kansas Water Well Contractor's License No. 527 This Water Well Record was completed on (mo/day/yr) 2/17/2006 under the business name of GeoCore, Inc. by (signature) Dan Robt